

MAR 29 2000

SECTION

LAND CORNER RECORDATION CERTIFICATE
Filing Requirement of Act 74, Mich. P.A. 1970

Approved by Menominee County
Land Survey Remonumentation
Peer Group Under Act 345 Of

P.A. Of 1990 On 12/23 1999
Mike Davis PLS
Chairman

For corners in

MENOMINEE (County)	Located In:	Corner Code #
1. Public Land Survey	T <u>35</u> N R <u>28</u> W	<u>II-09</u>
	T <u> </u> R <u> </u>	<u> </u>
	T <u> </u> R <u> </u>	<u> </u>
	T <u> </u> R <u> </u>	<u> </u>
2. Property Controlling in Section	S <u> </u> T <u> </u> R <u> </u>	<u> </u>
	S <u> </u> T <u> </u> R <u> </u>	<u> </u>
3. Miscellaneous Property in Sec.	S <u> </u> T <u> </u> R <u> </u>	<u> </u>
	S <u> </u> T <u> </u> R <u> </u>	<u> </u>

BK. 6 Pg. 67

RECEIVED FOR RECORD
28 DEC 1999 3:56:09 PM
BARBARA MORRISON
REGISTER OF DEEDS
MENOMINEE, MI 49858

Register of Deeds Stamp & File Number

4. Lot No. _____, Recorded Plat _____
5. Private Claims _____

I, William Lenca, in a field survey on Nov., 19 99 do hereby state that under requirements of P.A. 74, Michigan P.A. of 1970, the corner points mentioned in lines 1 and 2 above were in conformance with regulations and rules therefore as required in the current manual of survey instructions of the United States Department of the Interior, Bureau of Land Management or by a decree of a Court of Law and /or that the corner points mentioned in lines 3, 4 and 5 above were in conformance with the rules of the Michigan Board of Land Surveyors or by a Decree of a Court of Law; established, re-established, monumented, recovered, found as expressed below:

	A	B	C	D	E	F	G	H	I	J	K	L	M
1													
2		6		5		4		3		2		1	
3													
4		7		8		9		10		11		12	
5													
6		18		17		16		15		14		13	
7													
8		19		20		21		22		23		24	
9								27		26		25	
10		30		29		28		27		26		25	
11													
12		31		32		33		34		35		36	
13													

NOTE: Not more than 2 corners, all in the same town and range, may be recorded on this certificate.

A. Description of original monument and accessories and/or subsequent restoration:

- 1852: Original Survey by Francis Coleman - B.T.'s - Tamarack, 10" - N27°W - 30 lks.; Tamarack, 14" - S56°E - 27 lks. All original evidence for this corner has been destroyed by county road improvements.
- 1988: L.C.R.C. Number 834 by David B. Babbitt states, "Set in centerline of E-W blacktop road and equal distance from the SE and SW section corners of Section 22 - 2631.36 ft. each way." Set Menominee Co. Monument. TIES: Tamarack, 8" - N11°W - 52.4'; Cedar, 9" - N25°E - 58.2'; Tamarack, 4" - S10°E - 53.8'; Tamarack, 8" - S29°W - 63.0'.


B. Description of corner evidence found and/or method applied in restoring or reestablishing corner:

We recovered a W-1-B Berntsen Monument with a broken top in the centerline of an East - West County Road, along with 4 B.T.'s as described in LCRC No. 834 (see part "A"). The measurement to corners 1/2 mile East and 1/2 mile West is 2631.46 feet. This corner has been used by local surveyors for over 10 years, and is accepted as the best available evidence of the position of the original corner.

C. Description of monument for corner and accessories established to perpetuate locating the position of the corner:

Set 5/8" x 24" Iron Rod/3-1/4" dia. Alum. cap stamped for corner location in Monument Box:

10" dia. Cedar (Ex. B.T.)	N25° E	58.73 feet	Scr. NBT
9" dia. Tamarack	S30° E	77.60 feet	Scr. NBT
9" dia. Tamarack (Ex. B.T.)	S29° W	63.33 feet	Scr. NBT
12" dia. Tamarack	N37° W	64.39 feet	Scr. NBT
Metal Survey Sign Post	North	33.60 feet	

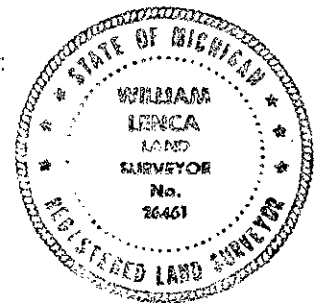

NOTE: All bearings are magnetic bearings. All distances are measured with steel tape. Distances to trees are to nail in side of tree.

Signed by William Lenca
Surveyor's Michigan License No. 26461

Date Nov. 23, 1999