

P.A. of 1990 On 9/25 19996

LAND CORNER RECORDATION CERTIFICATE  
Filing Requirement of Act 74, Mich. P.A. 1970

William Lenca  
Chairman

For corners in  
MENOMINEE  
(County)

Located In:	Corner Code #
T <u>35</u> N R <u>28</u> W	<u>105</u>
T___R___	_____
T___R___	_____
T___R___	_____
S___T___R___	_____
S___T___R___	_____
S___T___R___	_____
S___T___R___	_____

- Public Land Survey
- Property Controlling in Section
- Miscellaneous Property in Sec.

REGISTERED FOR RECORD

95 OCT -7 PM 3:26

REGISTER OF DEEDS

BARBARA MORRISON

REGISTER OF DEEDS


REGISTERED

Register of Deeds Stamp & File Number

4. Lot No. \_\_\_\_\_, Recorded Plat \_\_\_\_\_  
5. Private Claims \_\_\_\_\_

I, William Lenca, in a field survey on May 20, 1996, do hereby state that under requirements of P.A. 74, Michigan P.A. of 1970, the corner points mentioned in lines 1 and 2 above were in conformance with regulations and rules therefore as required in the current manual of survey instructions of the United States Department of the Interior, Bureau of Land Management or by a decree of a Court of Law and /or that the corner points mentioned in lines 3, 4 and 5 above were in conformance with the rules of the Michigan Board of Land Surveyors or by a Decree of a Court of Law; established, re-established, monumented, recovered, found as expressed below:

NOTE: Not more than 2 corners, all in the same town and range, may be recorded on this certificate.

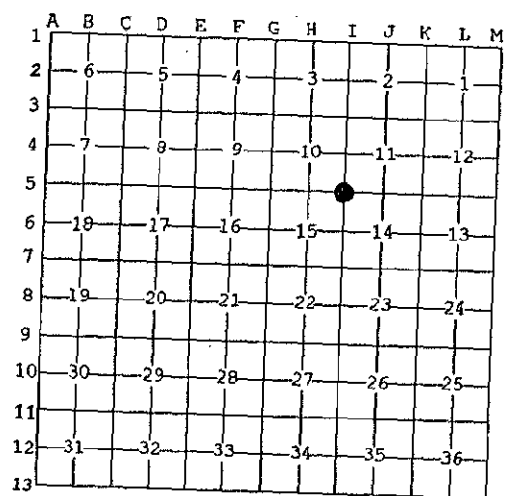

A. Description of original monument and accessories and/or subsequent restoration:

- 1852: Original Survey by Francis Coleman - B.T.'s - Cedar, 10" - N49°W - 39 lks - Not evident; Cedar, 12" - S32°E - 19 lks - stump found in 1960.
- 1960: L.C.R.C. No. 46 (Volume 2) recorded by Billy D. Buckler, RLS, states that a 1" pipe/4" brass cap was set from one Cedar B.T. bearing S32°E, 19 links. Stump in poor condition. Found old wood post with Roman Numerals. New B.T.'s - 8" Ced. - S38°E - 15.5 links; 8" Ced. - S21°W - 10.5 links; 9" Ced. - N34°E - 24.5 links.

B. Description of corner evidence found and/or method applied in restoring or reestablishing corner:

We found a 1" diameter Iron Pipe/4" cap marked "MICHIGAN DEPARTMENT OF CONSERVATION" and 3 B.T.'s as described in part "A" in good condition. The original Cedar stump is in very poor condition and no identifiable marks are visible, however the stump is in the proper position. We accepted the existing monument as a careful and faithful perpetuation of the position of the original corner.

C. Description of monument for corner and accessories established to perpetuate locating the position of the corner:

Accepted existing 1" Iron Pipe/4" brass cap marked "MICHIGAN DEPARTMENT OF CONSERVATION" and stamped for corner:

9" dia. Cedar	N03°E	12.07 feet	Scr. NBT
12" dia. Cedar	S90°E	18.05 feet	Scr. NBT
11" dia. Cedar (existing B.T.)	S21°W	7.10 feet	Scr. NBT
6" dia. Cedar	N80°W	12.98 feet	Scr. NBT

NOTE: All bearings are magnetic bearings. All distances are measured with steel tape. Distances to trees are to nail in side of tree.

Signed by William Lenca  
Surveyor's Michigan License No. 26461

Date May 31, 1996

