

SURVEY & REMONUMENTATION

OCT 27 1999

Approved by Menominee County
Land Survey Remonumentation
Peer Group Under Act 345 Of
P.A. Of 1990 On 10/11 1999
Ma. Davis RLS
Chairman

LAND CORNER RECORDATION CERTIFICATE
Filing Requirement of Act 74, Mich. P.A. 1970

SECTION
For corners in
MENOMINEE
(County)

Located In:	Corner Code #
T <u>36</u> N R <u>28</u> W	<u>J-13</u>
T ___ R ___	_____
T ___ R ___	_____
T ___ R ___	_____
S ___ T ___ R ___	_____
S ___ T ___ R ___	_____
S ___ T ___ R ___	_____
S ___ T ___ R ___	_____

- Public Land Survey
- Property Controlling in Section
- Miscellaneous Property in Sec.

RECEIVED FOR RECORD
99 OCT 15 PM 1:41
PAGE # 13 OF 6
BARBARA MORRISON
REGISTER OF DEEDS
MENOMINEE MI 49383
Register of Deeds Stamp & File Number

4. Lot No. _____, Recorded Plat _____
5. Private Claims _____

SAME AS CORNER J-1, T35N-R28W

I, William Lenca, in a field survey on Apr., 1999 do hereby state that under requirements of P.A. 74, Michigan P.A. of 1970, the corner points mentioned in lines 1 and 2 above were in conformance with regulations and rules therefore as required in the current manual of survey instructions of the United States Department of the Interior, Bureau of Land Management or by a decree of a Court of Law and for that the corner points mentioned in lines 3, 4 and 5 above were in conformance with the rules of the Michigan Board of Land Surveyors or by a Decree of a Court of Law; established, re-established, monumented, recovered, found as expressed below:

	A	B	C	D	E	F	G	H	I	J	K	L	M
1													
2	6			5			4			3			2
3													
4	7			8			9			10			11
5													
6	10			17			16			15			14
7													
8	19			20			21			22			23
9													
10	30			29			28			27			26
11													
12	31			32			33			34			35
13													

NOTE: Not more than 2 corners, all in the same town and range, may be recorded on this certificate.

A. Description of original monument and accessories and/or subsequent restoration:


- 1848: Original Survey by H. Brevoort - B.T.'s - W. Pine, 24" - N71°W - 44 lks; W. Pine, 36" - N62°E - 05 lks. Evidence of Tamarack stump still visible - poor condition.
- 1983: L.C.R.C. No. 583, Book 2 by David Babbitt, RLS No. 21558, - Set DNR Mon. M.P.O.L. between NE & NW Sec. Cors. Several W.P. Strips in the area, but too rotten & burned to show marks & none in proper relationship to each other to fit GLO record for OBT's. TIES: 4" Oak - N17°W - 17.35'; 5" Maple - N14°E - 10.85'; 5" Maple - S71°E - 22.8'; Tw. 5" Maple - S71°W - 28.6'

B. Description of corner evidence found and/or method applied in restoring or reestablishing corner:

We found a standard DNR Monument and 2 B.T.'s (5" Maple - N14°E - 10.85' & 5" Maple - S71°E - 22.8') in location as described in L.C.R.C. No. 583, Book 2 (see part "A"). Since this corner was re-monumented based on single proportional measurement, we accepted the existing corner monument as a careful and faithful reestablishment of the position of the original corner.

C. Description of monument for corner and accessories established to perpetuate locating the position of the corner:

- Accepted Existing 1-1/2" dia. Iron Pipe/4" Alum. Cap stamped for corner location.
- 10" dia. Maple N71°E 32.69 feet Scr. NBT
- 6" dia. Maple S22°E 24.51 feet Scr. NBT
- 8" dia. Maple N52°W 46.39 feet Scr. NBT
- 6" dia. Maple N14°E 11.08 feet (10.85' R) Scr. NBT
- Metal Survey Sign Post North 1.05 feet

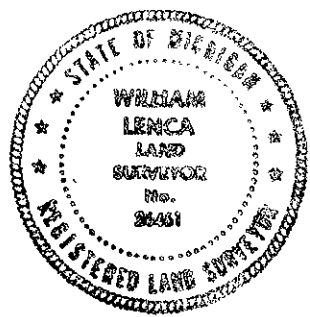

NOTE: All bearings are magnetic bearings. All distances are measured with steel tape. Distances to trees are to nail in side of tree.

Signed by William Lenca Date Sep. 15, 1999
Surveyor's Michigan License No. 26461