Approved by Menominee County
Land Survey Remonumentation
Peer Group Under Act 345 Of
P.A. Of 1990 On 9/25, 199 96
Chairman

LAND CORNER RECORDATION CERTIFICATE
Filing Requirement of Act 74, Mich. P.A. 1970

For corners in

MENOMINEE
(County)

		Located In:	Corner Code #
1. Public Land Survey		T35N R 28W	K03
		T___ R___	
		T___ R___	
		T___ R___	
2. Property Controlling	S___	T___ R___	
in Section	S___	T___ R___	
3. Miscellaneous	S___	T___ R___	
Property in Sec.	S___	T___ R___	

RECEIVED FOR RECORD
96 OCT -7 PM 3:26
PAGE # 360 BK. 4
BARBARA MORRISON
REGISTER OF DEEDS

Register of Deeds Stamp & File Number

4. Lot No. _____, Recorded Plat _____
5. Private Claims _____

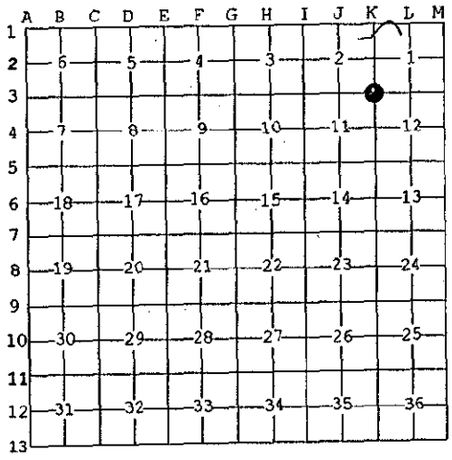

I, William Lenca, in a field survey on May 28, 19 96 do hereby state that under requirements of P.A. 74, Michigan P.A. of 1970, the corner points mentioned in lines 1 and 2 above were in conformance with regulations and rules therefore as required in the current manual of survey instructions of the United States Department of the Interior, Bureau of Land Management or by a decree of a Court of Law and /or that the corner points mentioned in lines 3, 4 and 5 above were in conformance with the rules of the Michigan Board of Land Surveyors or by a Decree of a Court of Law; established, re-established, monumented, recovered, found as expressed below:

NOTE: Not more than 2 corners, all in the same town and range, may be recorded on this certificate.

A. Description of original monument and accessories and/or subsequent restoration:

1852: Original Survey by Francis Coleman - B.T.'s - Beech, 12" - N56°E - 39 lks; W. Pine, 20" - S45°W - 60 lks. All original evidence for this corner has been destroyed by fire and logging activities.

B. Description of corner evidence found and/or method applied in restoring or reestablishing corner:

We reset this corner on an ancient fence line running East - West and at a proportional distance between the Northwest Corner (I-3) of Section 11and the North Quarter Corner (L-3) of Section 12, T35N-R28W. Our total measured distance was 7,953.09 feet compared to the GLO distance of 7945.0 feet. We accepted this location as the best available evidence of the position of the original corner.

STATE OF MICHIGAN
WILLIAM LENCA
LAND SURVEYOR
No. 26461
REGISTERED LAND SURVEYOR

C. Description of monument for corner and accessories established to perpetuate locating the position of the corner:
Set 2" dia. Aluminum Pipe/3-1/4" Aluminum cap stamped for corner location:

9" dia. Balsam	N08°E	41.32 feet	Scr. NBT
24" dia. White Pine	S42°E	64.82 feet	Scr. NBT
14" dia. White Pine	S20°W	55.92 feet	Scr. NBT
10" dia. Maple	N87°W	83.20 feet	Scr. NBT

NOTE: All bearings are magnetic bearings. All distances are measured with steel tape. Distances to trees are to nail in side of tree.

Signed by William Lenca
Surveyor's Michigan License No. 26461

Date May 31, 1996

FORM APPROVED BY MICHIGAN STATE BOARD OF PROFESSIONAL SURVEYORS, JAN. 28, 1971
REVISED MAY 14,1975
REVISED JAN., 1983
REVISED OCT., 1995