

APR 06 1998

Approved by Menominee County
Land Survey Remonumentation
Peer Group Under Act 345 Of

P.A. Of 1990 On 12/30, 1998

McDouglas RLS
Chairman

SECTION

LAND CORNER RECORDATION CERTIFICATE
Filing Requirement of Act 74, Mich. P.A. 1970

For corners in

MENOMINEE

(County)

Located In:

Corner Code #

1. Public Land Survey

T35N R 28W

L-11

T R

T R

T R

T R

2. Property Controlling
in Section

S

T R

S

T R

3. Miscellaneous
Property in Sec.

S

T R

S

T R

4. Lot No. _____, Recorded Plat _____

5. Private Claims _____

RECEIVED FOR RECORD
99 JAN - 6 AM 8:51
PAGE # 694 BK 5
BARBARA MORRISON
REGISTER OF DEEDS
MENOMINEE, MI 49858

Register of Deeds Stamp & File Number

I, William Lenca, in a field survey on Sept. 16, 1998 do hereby state that under requirements of P.A. 74, Michigan P.A. of 1970, the corner points mentioned in lines 1 and 2 above were in conformance with regulations and rules therefore as required in the current manual of survey instructions of the United States Department of the Interior, Bureau of Land Management or by a decree of a Court of Law and/or that the corner points mentioned in lines 3, 4 and 5 above were in conformance with the rules of the Michigan Board of Land Surveyors or by a Decree of a Court of Law; established, re-established, monumented, recovered, found as expressed below:

NOTE: Not more than 2 corners, all in the same town and range, may be recorded on this certificate.

	A	B	C	D	E	F	G	H	I	J	K	L	M
1													
2	6		5		4		3		2		1		
3													
4	7		8		9		10		11		12		
5													
6	18		17		16		15		14		13		
7													
8	19		20		21		22		23		24		
9													
10	30		29		28		27		26		25		
11													
12	31		32		33		34		35		36		
13													

A. Description of original monument and accessories and/or subsequent restoration:

- 1852: Original Survey by Francis Coleman - B.T.'s - Maple, 9" - N51°E - 18 lks.; W. Pine, 22" - S15°W - 61 lks. All original evidence for this corner has been destroyed by logging activities.
- 1964: Plat of Survey by Robert Olsen, shows this corner as it relates to other corners in Section 36, T35N-R28W. The corner is described as "Corner Fence Post on S. side of Road".
- 1990: L.C.R.C. Number 889 by William Lenca states, "Re-established corner in position used by Robert Olsen, RLS 10700, in a survey dated 12/12/64." Set Railroad Spike (due to frost depth). TIES: Oak, 8" - S32°E - 34.80'; Maple, 9" - S69°W - 15.55'; Maple, 8" - N55°W - 73.31'; Oak, 9" - N54°E - 71.44'; R.R. Spike - S41°E - 1.03'.


B. Description of corner evidence found and/or method applied in restoring or reestablishing corner:

We found an existing 2 inch x 30 inch Aluminum Pipe with a 3-1/4 inch diameter aluminum cap at an old fence corner in a location as indicated in Land Corner Recordation Certificate Number 889 (Note: We set the monument in place of the railroad spike when the ground thawed). All 4 above bearing trees were also found in good condition and match the monumented position. This location has been used for over 34 years and is accepted as the best available evidence of the position of the original corner.

C. Description of monument for corner and accessories established to perpetuate locating the position of the corner:

Accepted existing 2" dia. Aluminum Pipe 30" long/3-1/4" dia. Alum cap stamped for corner location:

8" dia. Oak	S32°E	34.80 feet	Ex. BT
9" dia. Maple	S69°W	15.55 feet	Ex. BT
8" dia. Maple	N55°W	73.31 feet	Ex. BT
9" dia. Oak	N54°E	71.44 feet	Ex. BT
Metal Survey Sign Post	S70°W	12.6 feet	

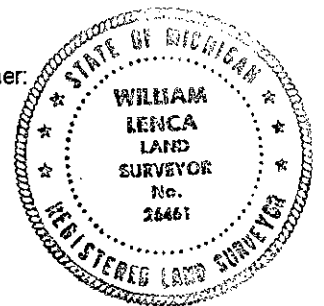

NOTE: All bearings are magnetic bearings. All distances are measured with steel tape. Distances to trees are to nail in side of tree.

Signed by William Lenca

Date Dec. 22, 1998

Surveyor's Michigan License No. 26461