SURVEY & REMONUMENTATION

FEB 1 1 1998

proved by Monomines County Land Survey Remons Poer Group Under Act 345 Of


Filing Requirement of Act 74, Mich. P.A. 1970

P.A. Of 1990 On LAND CORNER RECORDATION CERTIFICATE

SE	ÇŢ	ľΩľ	Į.
	יוטיק		3 II


MENOMINEE	Located In:	Corner Code #	
(County)			
1. Public Land Survey	T36N R_ T3		
Property Controlling in Section Miscellaneous Property in Sec.	S TR_ S TR_ S TR		

Register of Deeds Stamp & File Number

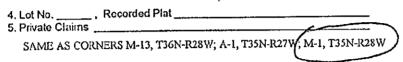

I. William Lonca , in a field survey on Scpt 29 19 97 do hereby state that under requirements of P.A. 74, Michigan P.A. of 1970, the corner points mentioned in lines 1 and 2 above were in conformance with regulations and rules therefore as required in the current manual of survey instructions of the United States Department of the Interior, Bureau of Land Management or by a decree of a Court of Law and for that the corner points mentioned in lines 3, 4 and 5 above were in conformance with the rules of the Michigan Board of Land Surveyors or by a Decree of a Court of Law; established, re-established, monumented, recovered found as expressed below: recovered, found as expressed below:

NOTE: Not more than 2 comers, all in the same town and range, may be recorded on this certificate.

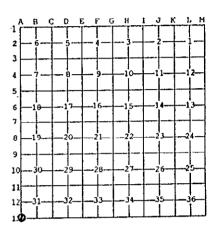

MALLETY LENCA LAND

CEED LAND

A. Description of original monument and accessories and/or subsequent restoration:

Original Survey by H. Floyd - B.T.'s - Cedar, 11" - N33°E - 42 lks.; Tamarack, 8" - N10°W - 20 lks. All original evidence for this corner has been destroyed by county road improvements.

B. Description of corner evidence found and/or method applied in restoring or reestablishing corner:

My private records indicate that in a 1993 survey we established this corner in the centerline of an East - West County Road and at a single proportionate distance between the S1/4 of Section 36, T36N - R28 and the S1/4 of Section 31, T36N - R27W and monumented this position with a railroad spike. We recovered this railroad spike and accepted it as a careful and faithful of Dicole reestablishment of the position of the original corner.

C. Description of monument for corner and accessories established to perpetuate locating the position of the corner: Set 5/8" x 24" Iron Rod/3-1/4" dia. Alum. cap stamped for corner location in Monument Box:

10 ⁿ dia. Cedar	N430E	62.90 feet	Scr. NBT
6" dia. Elm	S490W	59.84 feet	Scr. NBT
12" dia. White Pine	N180M	60.97 feet	Scr. NBT
5/8" x 24" Iron Rod/2" dia. Alum, cap marked "WITNESS MARKER"	South	25,53 feet	
Metal Survey Sign Post	South	26.0 feet	•

NOTE: All bearings are magnetic bearings. All distances are measured with steel tape. Distances to trees are to nail in side of tree,

0/00/	•	Oct. 13, 1997
Signed by 12 Irany Frace		Date
Surveyor's Michigan License No. 26461	_	