

MAR 29 2000

SECTION

LAND CORNER RECORDATION CERTIFICATE  
Filing Requirement of Act 74, Mich. P.A. 1970

Approved by Menominee County  
Land Survey Remonumentation  
Peer Group Under Act 345 Of

P.A. Of 1990 On 10/11 1999  
Mc. Davis RLS  
Chairman

For corners in

MENOMINEE  
(County)

Located In:

Corner Code #

- |                                    |   |             |            |             |
|------------------------------------|---|-------------|------------|-------------|
| 1. Public Land Survey              | T | <u>35NR</u> | <u>27W</u> | <u>A-08</u> |
|                                    | T | _____       | _____      | _____       |
|                                    | T | _____       | _____      | _____       |
|                                    | T | _____       | _____      | _____       |
| 2. Property Controlling in Section | S | _____       | _____      | _____       |
|                                    | S | _____       | _____      | _____       |
| 3. Miscellaneous Property in Sec.  | S | _____       | _____      | _____       |
|                                    | S | _____       | _____      | _____       |

BK 6 Pg. 92

RECEIVED FOR RECORD  
28 DEC 1999 3:56:09 PM  
BARBARA MORRISON  
REGISTER OF DEEDS  
MENOMINEE, MI 49858

Register of Deeds Stamp & File Number

4. Lot No. \_\_\_\_\_, Recorded Plat \_\_\_\_\_  
5. Private Claims \_\_\_\_\_  
(SAME AS CORNER M-08 T35N - R28W)

	A	B	C	D	E	F	G	H	I	J	K	L	M
1													
2	6		5		4		3		2		1		
3													
4	7		8		9		10		11		12		
5													
6	18		17		16		15		14		13		
7													
8	19		20		21		22		23		24		
9													
10	30		29		28		27		26		25		
11													
12	31		32		33		34		35		36		
13													

I, William Lenca in a field survey on Oct., 1999 do hereby state that under requirements of P.A. 74, Michigan P.A. of 1970, the corner points mentioned in lines 1 and 2 above were in conformance with regulations and rules therefore as required in the current manual of survey instructions of the United States Department of the Interior, Bureau of Land Management or by a decree of a Court of Law and /or that the corner points mentioned in lines 3, 4 and 5 above were in conformance with the rules of the Michigan Board of Land Surveyors or by a Decree of a Court of Law; established, re-established, monumented, recovered, found as expressed below:

NOTE: Not more than 2 corners, all in the same town and range, may be recorded on this certificate.

A. Description of original monument and accessories and/or subsequent restoration:

- 1847: Original Survey by H. Floyd - B.T.'s - Y. Pine, 20" - N51°W - 64 lks.; Cedar, 10" - S25°W - 25 lks. All original evidence for this corner has been destroyed by logging activities.
- 1989: L.C.R.C. No. 852 (Bk 3) by William Lenca, RLS No. 26461, states set 3/4" x 5' County Monument/2-1/2" dia. cap marked for corner location in line with ancient fences E - W - S. TIES: Spruce, 8" - S54°E - 36.08'; W. Pine, 16" - S43°W - 58.27'; Spruce, 12" - N44°W - 26.35'; Carsonite Marker - South - 2.75'.


B. Description of corner evidence found and/or method applied in restoring or reestablishing corner:

We recovered a 3/4 inch diameter aluminum rod with a 3-1/4 inch diameter aluminum cap and ties as described in L.C.R.C. No. 852 (see part "A"). The corner monument is at an ancient fence corner and fits well with measurements to corners 1/2 mile North (2643.27") and 1/2 mile South (2632.10'), and is accepted as the best available evidence of the position of the original corner.

C. Description of monument for corner and accessories established to perpetuate locating the position of the corner:

Accepted existing 3/4" x 5' long aluminum rod/3-1/4" dia. Alum. cap stamped for corner:

10" dia. W. Spruce (EX)	S 54° E	36.03 feet	Scr. NBT
18" dia. W. Pine (EX)	S 43° W	58.20 feet	Scr. NBT
15" dia. W. Spruce (EX)	N 44° W	26.35 feet	Scr. NBT
9" dia. W. Spruce	S 18° E	34.80 feet	Scr. NBT
Carsonite Marker	North	0.50 feet	

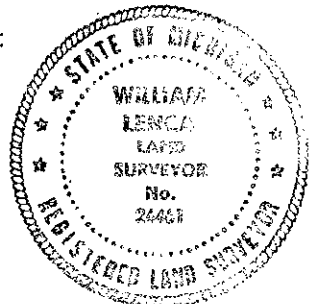

NOTE: All bearings are magnetic bearings. All distances are measured with steel tape. Distances to trees are to nail in side of tree.

Signed by William Lenca  
Surveyor's Michigan License No. 26461

Date Nov 2, 1999