

SURVEY
RECORD

APR 06 1999

Approved by Menominee County
Land Survey Remonumentation
Peer Group Under Act 345 Of
P.A. Of 1990 On 12/30 1998
Mc Davis RLS

LAND CORNER RECORDATION CERTIFICATE
Filing Requirement of Act 74, Mich. P.A. 1970

For corners in SECTION

MENOMINEE

(County)

Located In:

Corner Code #

1. Public Land Survey

T 35N R 27W

A-10

T _____ R _____

T _____ R _____

T _____ R _____

T _____ R _____

2. Property Controlling
in Section

S _____

T _____ R _____

S _____

T _____ R _____

3. Miscellaneous
Property in Sec.

S _____

T _____ R _____

S _____

T _____ R _____

4. Lot No. _____, Recorded Plat _____

5. Private Claims _____

(SAME AS CORNER M-10 T35N - R28W)

I, William Lenca, in a field survey on May 18, 19 98 do hereby state that under requirements of P.A. 74, Michigan P.A. of 1970, the corner points mentioned in lines 1 and 2 above were in conformance with regulations and rules therefore as required in the current manual of survey instructions of the United States Department of the Interior, Bureau of Land Management or by a decree of a Court of Law and/or that the corner points mentioned in lines 3, 4 and 5 above were in conformance with the rules of the Michigan Board of Land Surveyors or by a Decree of a Court of Law; established, re-established, monumented, recovered, found as expressed below:

NOTE: Not more than 2 corners, all in the same town and range, may be recorded on this certificate.

A. Description of original monument and accessories and/or subsequent restoration:

- 1847: Original Survey by John Mullett - B.T.'s - W. Pine, 36" - N65°W - 24 lks.; Y. Pine, 24" - S52°W - 87 lks. All original evidence for this corner has been destroyed by county road improvements.
- 1987: Plat of Survey by William Lenca, RLS No. 26461, shows this corner as it relates to other corners in Section 25, T35N-R28W.
- 1996: Certified Survey No. 867 by William Lenca shows he set a railroad spike at this corner.


B. Description of corner evidence found and/or method applied in restoring or reestablishing corner:

In our 1987 survey noted in part "A" above, we monumented this corner with a Railroad Spike. In our 1998 remonumentation survey, we recovered a railroad spike in the centerline of a North - South county road and in line with an old fence to the West, which fits with the position as shown in the 1987 survey. This corner position has been used in several surveys, and is accepted as the best available evidence of the position of the original corner.

C. Description of monument for corner and accessories established to perpetuate locating the position of the corner:

Set 5/8" x 24" Iron Rod/3-1/4" dia. Alum. cap stamped for corner location in Monument Box:

7" dia. Triple Maple	N68°E	62.98 feet	Scr. NBT
8" dia. W. Pine	S16°E	91.77 feet	Scr. NBT
10" dia. Maple	S88°W	64.83 feet	Scr. NBT
6" dia. W. Pine	N36°W	72.22 feet	Scr. NBT
Metal Survey Sign Post	East	39.5 feet	

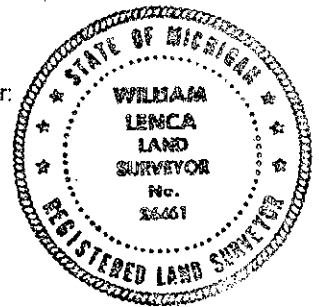

NOTE: All bearings are magnetic bearings. All distances are measured with steel tape. Distances to trees are to nail in side of tree.

Signed by William Lenca

Date Dec. 22, 1998

Surveyor's Michigan License No. 26461

RECEIVED FOR RECORD
99 JAN - 6 AM 8:54
PAGE # 708 BK 5
BARBARA MORRISON
REGISTER OF DEEDS
MENOMINEE, MI 49856
Register of Deeds Stamp & File Number

1	A	B	C	D	E	F	G	H	I	J	K	L	M
2		6		5		4		3		2		1	
3													
4		7		8		9		10		11		12	
5													
6		10		17		16		15		14		13	
7													
8		19		20		21		22		23		24	
9													
10		30		29		28		27		26		25	
11													
12		31		32		33		34		35		36	
13													