SEC. 6
T35N-R28W
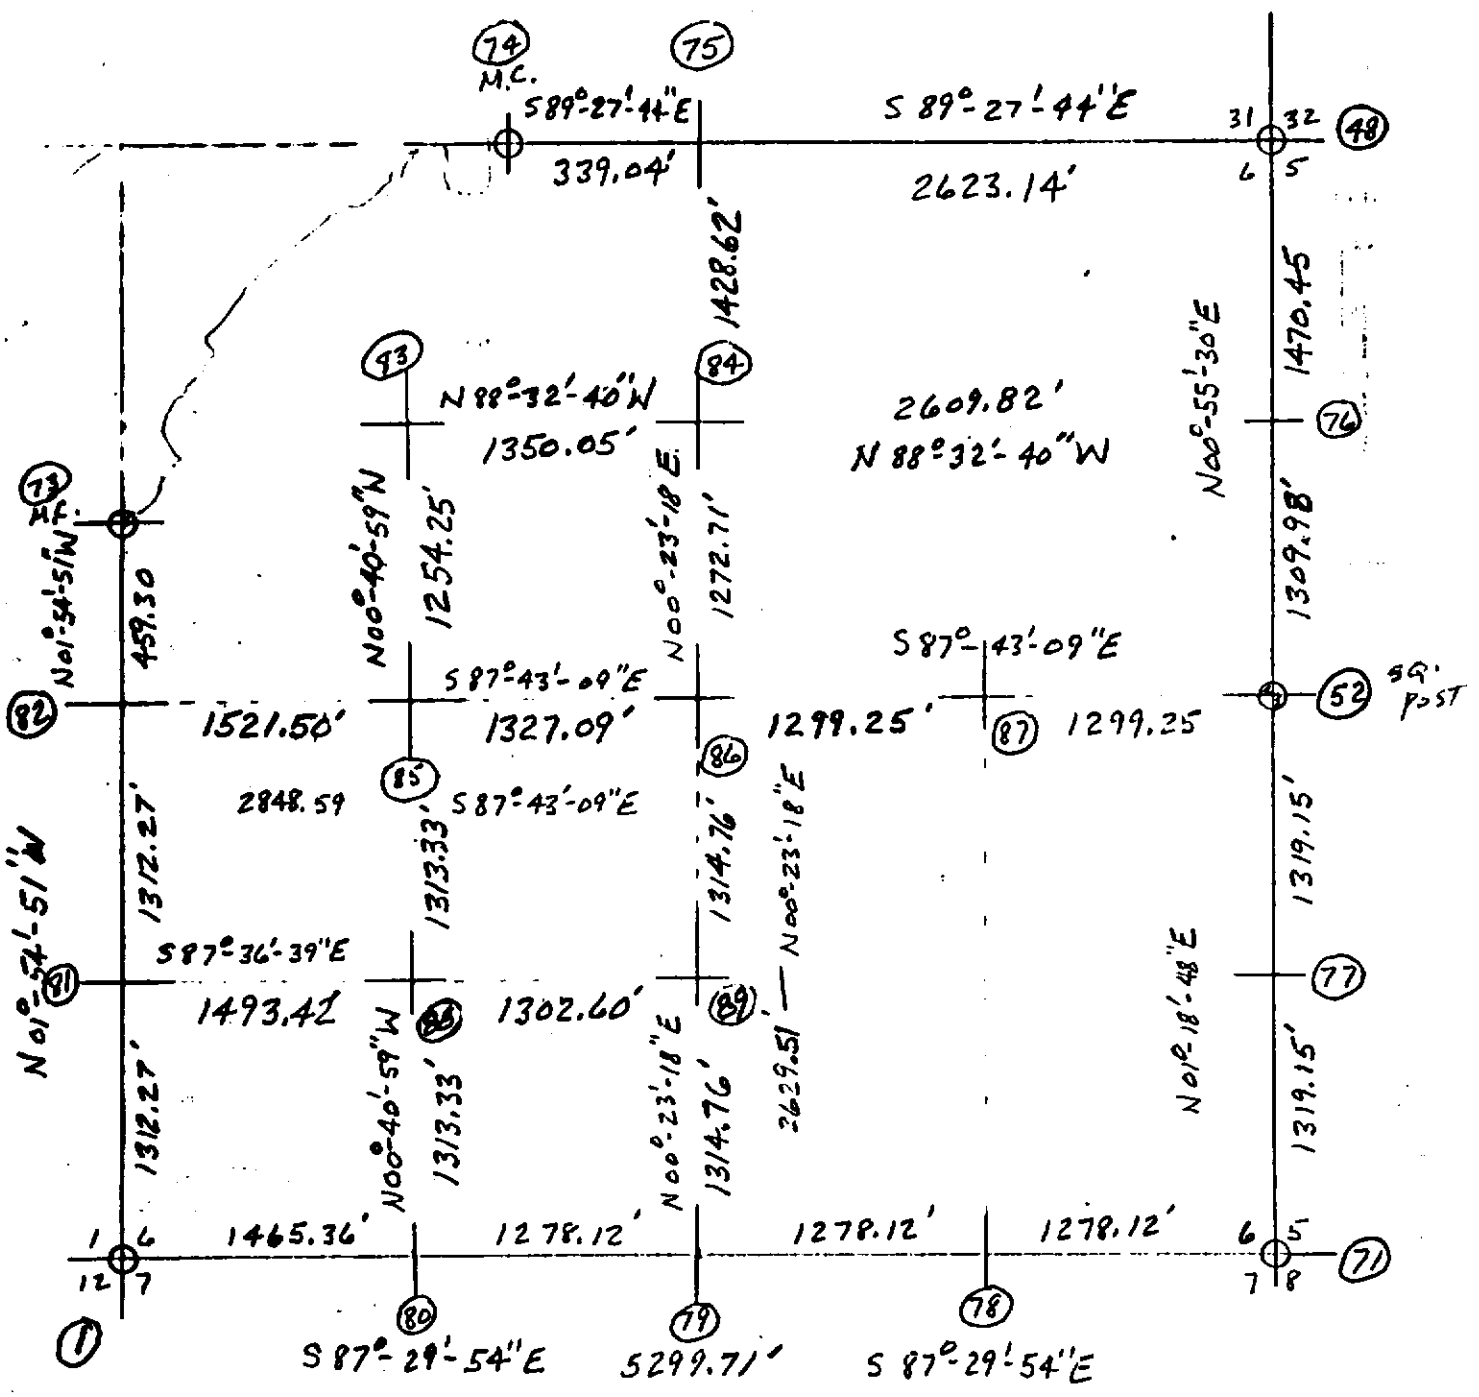
8-27-86 D.B.