

APR 06 1999

SECTION

Approved by Menominee County
Land Survey Remonumentation
Peer Group Under Act 345 Of

P.A. of 1990 On 12/14, 1998
Terrence J. Wainio P.S.
Chairman

LAND CORNER RECORDATION CERTIFICATE
Filing Requirement of Act 74, Mich. P.A. 1970

For corners in

MENOMINEE
(County)

Located In: Corner Code #

- 1. Public Land Survey T35N R 29W J-11
T R
T R
T R
- 2. Property Controlling in Section S T R
S T R
- 3. Miscellaneous Property in Sec. S T R
S T R

RECEIVED FOR RECORD
50 DEC 14 PM 3:22
PAGE # 684 BK 5
BARBARA NEFFSON
REGISTER OF DEEDS
MENOMINEE, MI 49850

Register of Deeds Stamp & File Number

- 4. Lot No. , Recorded Plat
- 5. Private Claims

I, William Lenca, in a field survey on May 19, 1998 do hereby state that under requirements of P.A. 74, Michigan P.A. of 1970, the corner points mentioned in lines 1 and 2 above were in conformance with regulations and rules therefore as required in the current manual of survey instructions of the United States Department of the Interior, Bureau of Land Management or by a decree of a Court of Law and /or that the corner points mentioned in lines 3, 4 and 5 above were in conformance with the rules of the Michigan Board of Land Surveyors or by a Decree of a Court of Law; established, re-established, monumented, recovered, found as expressed below:

NOTE: Not more than 2 corners, all in the same town and range, may be recorded on this certificate.

A	B	C	D	E	F	G	H	I	J	K	L	M
1												
2	6	5	4	3	2	1						
3												
4	7	8	9	10	11	12						
5												
6	18	17	16	15	14	13						
7												
8	19	20	21	22	23	24						
9												
10	30	29	28	27	26	25						
11												
12	31	32	33	34	35	36						
13												

A. Description of original monument and accessories and/or subsequent restoration:

- 1852: Original Survey by Francis Coleman - B.T.'s - Spruce Pine, 6" - N55°E - 15 lks.; Spruce Pine, 6" - S74°W - 39 lks. All original evidence for this corner has been destroyed by county road improvements.
- 1953: Plat of Survey by Keith Roberts shows a steel rod and a cedar post at this corner location.
- 1964: Plat of Survey by Robert Olsen shows a steel rod at this corner location. TIES: Power Pole - N.E. - 41.7'; Jack Pine, 15" - S.E. - 51.0'; Oak, 12" - S.W. - 52.5'. (B.T.'s destroyed).

B. Description of corner evidence found and/or method applied in restoring or reestablishing corner:

We found a 5/8" x 24" Iron Rod and the point of an old wooden stake 5' North of the centerline of a County Road curve to the Southwest. This position fits the County Road centerline to the East and falls in line with an ancient fence to the West. This position has been used for nearly 45 years, fits existing lines of occupation, and is accepted as the best available evidence of the position of the original corner.

C. Description of monument for corner and accessories established to perpetuate locating the position of the corner:


Set 2" dia. Aluminum Pipe/3-1/4" dia. Alum cap stamped for corner location:

- 5/8" x 24" Iron Rod/2" dia. Alum. cap marked "WITNESS MARKER" North 24.85 feet
- 14" dia. Jack Pine S64°E 64.94 feet Scr. NBT
- 18" dia. Norway Pine S22°W 60.19 feet Scr. NBT
- 10" dia. Norway Pine N51°W 33.70 feet Scr. NBT
- Metal Survey Sign Post North 25.4 feet

NOTE: All bearings are magnetic bearings. All distances are measured with steel tape. Distances to trees are to nail in side of tree.

Signed by William Lenca
Surveyor's Michigan License No. 26461

Date Dec. 10, 1998

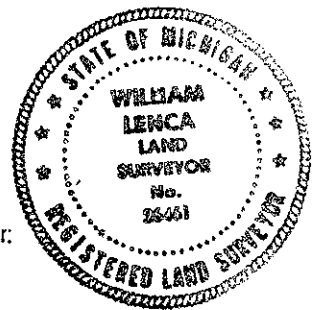

684