

SURVEY & REMONUMENTATION

APR 24 1995

COMMISSION

LAND CORNER RECORDATION CERTIFICATE Filing Requirement of Act 74, Mich. P.A. 1970

Approved by Menominee County
Land Survey Remonumentation
Peer Group Under Act 345 Of
P.A. Of 1990 On Dec 9 1994
William Fina
Chairman

For corners in

Menominee <small>(County)</small>	Located In:	Corner Code ##	
1. Public Land Survey	T <u>36N</u> R <u>25W</u>	<u>M-11</u>	
	T <u>36N</u> R <u>24W</u>	<u>A-11</u> ✓	
	T _____ R _____	_____	
	T _____ R _____	_____	
2. Property Controlling in Section	S _____ T _____ R _____	_____	
	S _____ T _____ R _____	_____	
3. Miscellaneous Property in Sec.	S _____ T _____ R _____	_____	
	S _____ T _____ R _____	_____	

RECEIVED FOR RECORD
 94 DEC 12 AM 8:55
 PAGE # 87 BK 4
 BARBARA MORRISON
 REGISTER OF DEEDS
 MENOMINEE COUNTY, MICHIGAN

Register of Deeds Stamp & File Number

4. Lot No. _____, Recorded Plat _____
 5. Private Claims _____

	A	B	C	D	E	F	G	H	I	J	K	L	M
2	6	5	4	3	2	1							
3													
4	7	8	9	10	11	12							
5													
6	18	17	16	15	14	13							
7													
8	19	20	21	22	23	24							
9													
10	30	29	28	27	26	25							
11													
12	31	32	33	34	35	36							
13													

Robert E. Schmeling a field survey on September 20, 1994, do hereby certify that under requirements of P.A. 74, Michigan P.A. of 1970, the corner points mentioned in lines 1 and 2 above were in conformance with regulations and rules therefore as required in the current manual of survey instructions of the United States Department of the Interior, Bureau of Land Management or by a decree of a Court of Law and/or that the corner points mentioned in lines 3, 4 and 5 above were in conformance with the rules of the Michigan Board of Land Surveyors or by a Decree of a Court of Law; established, re-established, monumented, re-monumented, recovered, found as expressed below:

NOTE: Not more than 4 corners, all in the same town and range, may be recorded on this certificate.

A. Description of original monument and accessories and/or subsequent restoration:


Corner common to Sections 30 and 31, T36N, R24W and Sections 25 and 36, T36N, R25W. Original wood post set by Deputy Surveyor John Mullett July 17, 1848 as a corrected position from a post set on September 29, 1847. Witnesses to corrected corner Poplar 14 S25W 05 links and Poplar 10 N55W 23 links. Mr. Mullett in subdividing T36N, R24W on July 18, 1848 set two additional witnesses: Cedar 6 N3E 05 links and Cedar 8 S22E 19 links.

Frank J. Bray, MDNR, May 15, 1968 found a wood post and points of two rotted post which he replaced with a 1" iron pipe with a 4" aluminum cap. He also noted old blazes on trees facing and near corner. He made witnesses: W. Pine 8 S28E 17 links, W. Cedar 11 N65W 40 links, and W. Pine 8 S22W 20 links. Bray's report recorded Vol. 3, Page 648 in

B. Description of corner evidence found and/or method applied in restoring or reestablishing corner:
 Found and left in place Bray's iron pipe. His cedar 11" Menominee County Survey records. now a cut stump with NBT, his pine SE now a 10" live tree scribed S31 NBT, and his pine SW now a 9" live tree scribed S36 NBT. No visible evidence of Mullett's original witnesses. Accepted Bray's above noted pipe as the best available evidence of the position of the original corner.

C. Description of monument for corner and accessories established to perpetuate locating the position of the corner:
 Made a new witness:
 White Cedar 12" S75W 34.7Ft to C of tree & PK nail (Scribed: S36 T36N R25W NBT)

Placed a steel fence post 2' SW of monument. Set a 4" cedar stake 2' north of monument. At eye level nailed a metal bearing tree poster to each witness tree and the fence post. All bearings are magnetic. Assisted by Mel Karkkainen and Joe Ricci of Escanaba.

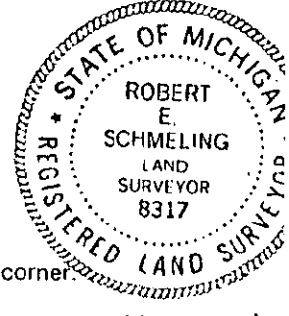

Signed by *Robert E. Schmeling* Date September 21, 1994
 Surveyor's Michigan License No. 8317