

MAY 28 1997

COMMISSION

Approved by Menominee County
Land Survey Remonumentation
Peer Group Under Act 345 Of

P.A. Of 1990 On 12/27, 1996

Mr. David RLS
Chairman

LAND CORNER RECORDATION CERTIFICATE
Filing Requirement of Act 74, Mich. P.A. 1970

For corners in

<u>MENOMINEE</u> (County)	Located In:	Corner Code #
1. Public Land Survey	<u>T36N R 24W</u>	<u>F01</u>
	T ___ R ___	_____
	T ___ R ___	_____
	T ___ R ___	_____
2. Property Controlling in Section	S ___ T ___ R ___	_____
	S ___ T ___ R ___	_____
3. Miscellaneous Property in Sec.	S ___ T ___ R ___	_____
	S ___ T ___ R ___	_____


REGISTERED FOR RECORD
97 JAN 17 AM 8:45
PAGE # 483, BKS
BARBARA MORRISON
REGISTER OF DEEDS
MENOMINEE, MI 49832

Register of Deeds Stamp & File Number

4. Lot No. _____, Recorded Plat _____
5. Private Claims _____

(SAME AS CORNER F13, T37N-R24W)

I, William Lenca, in a field survey on Apr. 23, 19 96 do hereby state that under requirements of P.A. 74, Michigan P.A. of 1970, the corner points mentioned in lines 1 and 2 above were in conformance with regulations and rules therefore as required in the current manual of survey instructions of the United States Department of the Interior, Bureau of Land Management or by a decree of a Court of Law and/or that the corner points mentioned in lines 3, 4 and 5 above were in conformance with the rules of the Michigan Board of Land Surveyors or by a Decree of a Court of Law; established, re-established, monumented, recovered, found as expressed below:

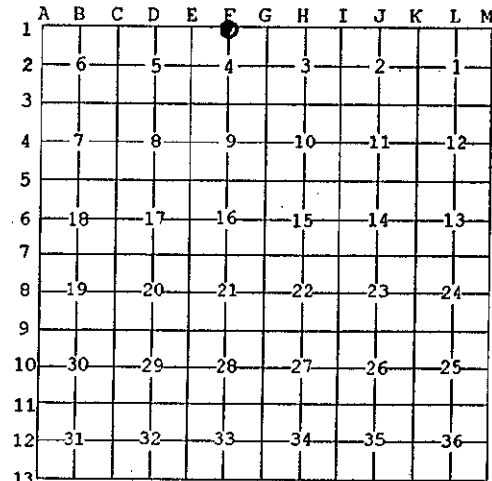

NOTE: Not more than 2 corners, all in the same town and range, may be recorded on this certificate.

A. Description of original monument and accessories and/or subsequent restoration:

- 1848: Original Survey by John Mullett - B.T.'s - Cedar, 10" - N77°W - 26 lks.; Cedar, 8" - N68°E - 18 lks. No original evidence for this corner was recovered.
- 1922: Survey by Marcus McNabb, Surveyor, states: "stake in place - B.T.'s - Bal. stump, 10" - N10°W - 8; Ced. Stump, 8" - S55°W - 33 ft. (No evidence of B.T. stumps - found old squared wood post.)
- 1979: Certified Survey No. 153 by George B. Wilson, RLS No. 17607, shows the position of this corner as it relates to other existing corner monuments in Section 4, but does not show or describe a corner monument.

B. Description of corner evidence found and/or method applied in restoring or reestablishing corner:

We recovered the Northeast Corner of Section 4 (1-1/2" diameter iron pipe) and the E1/16 Corner on the North Line of Section 4 (3/4" diameter iron pipe/Davis cap). By extending the line between these corners to the West and doubling the distance, we recovered an old squared wood post about the right type and age of that set by M.S. McNabb. This post was apparently used in establishing the 1/16 corner to the East. This position fits well with a GLO terrain call 1 chain East to a swamp edge. We accepted the position of the old wood post as the best available evidence to the position of the original corner.

C. Description of monument for corner and accessories established to perpetuate locating the position of the corner:
Set 2" dia. Aluminum Pipe/3-1/4" dia. Alum. cap stamped for corner location:

10" dia. Cedar	N90°E	76.96 feet	Scr. NBT
14" dia. Cedar	S63°W	14.98 feet	Scr. NBT
12" dia. Cedar	N46°W	32.07 feet	Scr. NBT
Metal Survey Sign Post	South	1.1 feet	



NOTE: All bearings are magnetic bearings. All distances are measured with steel tape. Distances to trees are to nail in side of tree.

Signed by William Lenca
Surveyor's Michigan License No. 26461

Date Apr. 27, 1996