

1

LAND CORNER RECORDATION CERTIFICATE
Filing Requirement of Act 74, Mich. P.A. 1970

For corners in

Table with columns: Menominee (County), Located In, Corner Code. Rows include Public Land Survey, Property Controlling in Section, and Miscellaneous Property in Sec.

Register of Deeds Stamp & File Number

4. Lot No. , Recorded Plat
5. Private Claims

I, Paul Bressette, in a field survey on April 21, 1993, do hereby certify that under requirements of P.A. 74, Michigan P.A. of 1970, the corner points mentioned in lines 1 and 2 above were in conformance with regulations and rules therefore as required in the current manual of survey instructions of the United States Department of the Interior, Bureau of Land Management or by a decree of a Court of Law and/or that the corner points mentioned in lines 3, 4 and 5 above were in conformance with the rules of the Michigan Board of Land Surveyors or by a Decree of a Court of Law; established, re-established, monumented, re-monumented, recovered, found as expressed below:

NOTE: Not more than 4 corners, all in the same town and range, may be recorded on this certificate.

Grid table with columns A-M and rows 2-13. Contains numbers 1-36 and a dot in cell J9.

A. Description of original monument and accessories and/or subsequent restoration:


- J-9 Quarter Corner common to Sections 23 and 26. 1921: Menominee County Road Commission, A.L. Hillis, RCE. Road plan on file shows iron pin in centerline of county road.
K-9 Section Corner common to Sections 23, 24, 25 and 26. 1921: Menominee County Road Commission, A.L. Hillis, RCE. Road plan on file shows iron pin in centerline of county road.
L-9 Quarter Corner common to Sections 24 and 25. 1921: Menominee County Road Commission, A.L. Hillis, RCE. Road plan on file shows iron pin in centerline of county road.

B. Description of corner evidence found and/or method applied in restoring or reestablishing corner:

- J-9 No evidence of iron pin found. Corner position re-established by single proportion between the Southeast and Southwest corners of Section 23 using distances found in a description contained in the county road plans. Corner falls approximately 2 feet north of the centerline of the county road.
K-9 No evidence of iron pin found. Corner position re-established by single proportion between found section corners one mile east and one mile west and in the centerline of the county road using distances found in a description contained in the county road plans. Corner falls approximately 1 foot east of old fencelines north and south.
L-9 No evidence of iron pin found. Corner position re-established by single proportion between the Southeast and Southwest corners of Section 24 using distances found in a description contained in the county road plans. Distance checks fair to stream call west but it runs through a culvert under the road and may not be in the correct position.

C. Description of monument for corner and accessories established to perpetuate localing the position of the corner:

Table with columns: J-9 Menominee Co. Mon., K-9 Menominee Co. Mon., L-9 Menominee Co. Mon. Lists monument types and distances for each corner.

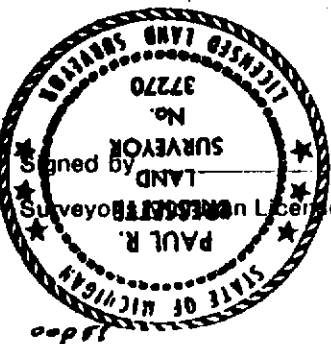

Paul R. Bressette

Date 9-28-93