

Approved by Menominee County  
 Land Survey Reestablishment  
 Peer Group Under Act 345 of  
 P.A. of 1990 On 10/26 1995  
Mike Davis RLS  
 Chairman

LAND CORNER RECORDATION CERTIFICATE  
 Filing Requirement of Act 74, Mich. P.A. 1970

for corners in


MENOMINEE Located-In: Corner Code 11  
 (County)

1. Public Land Survey	T <u>36N</u> R <u>26W</u>	B-3
	T _____ R _____	_____
	T _____ R _____	_____
	T _____ R _____	_____
2. Property Controlling in Section	S _____ T _____ R _____	_____
	S _____ T _____ R _____	_____
3. Miscellaneous Property in Sec.	S _____ T _____ R _____	_____
	S _____ T _____ R _____	_____

RECEIVED FOR RECORD  
 95 NOV - 8 AM 11:32  
 REGISTER OF DEEDS  
 BAYLATA HORTONSON  
 REGISTERED LAND SURVEYOR  
 MENOMINEE COUNTY MICHIGAN  
 Register of Deeds Stamp & File Number

- 4. Lot No. \_\_\_\_\_, Recorded Plat \_\_\_\_\_
- 5. Private Claims \_\_\_\_\_

William Lenca, in a field survey on Apr. 26, 1995,  
 do hereby certify that under requirements of P.A. 74, Michigan P.A. of 1970, the corner points mentioned  
 in lines 1 and 2 above were in conformance with regulations and rules therefore as required in the  
 current manual of survey instructions of the United States Department of the Interior, Bureau of Land  
 Management or by a decree of a Court of Law and/or that the corner points mentioned in lines 3, 4 and 5  
 above were in conformance with the rules of the Michigan Board of Land Surveyors or by a Decree of a  
 Court of Law; established, re-established, monumented, re-monumented, recovered, found as  
 expressed below:

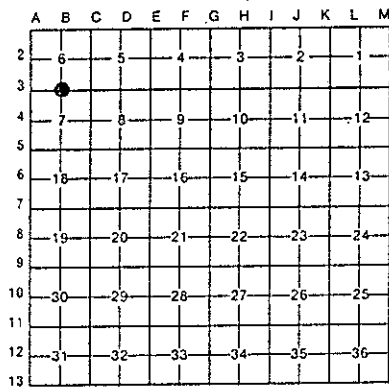

NOTE: Not more than 4 corners, all in the same town and range, may be recorded on this certificate.

A. Description of original monument and accessories and/or subsequent restoration:

1852: Original Survey by Francis Coicman - E.T.'s - Ironwood, 4" - S64°E - 24 lks; Hemlock, 6" - N73°W - 08 lks. All original evidence has been destroyed by road improvements and farming activities.

B. Description of corner evidence found and/or method applied in restoring or reestablishing corner:

The East-West position for this corner was established in line with a very old fence line running South, and with the centerline of a county road running North. This position fits well with an old fence occupation 1/2 mile to the East and 1/2 mile to the West. The North-South position for the corner was established by splitting the fences on either side of an old lane running East. The position thus arrived at is accepted as the best available evidence of the position of the original corner.

Description of monument for corner and accessories established to perpetuate locating the position of the corner:

- Set 2" dia. Aluminum Pipe 30" long w/3 1/4" Alum. Cap stamped for corner:
- 9" dia. Basswood N60°E 53.98 feet Scr. NBT
- "+" chisled in large rock S52°E 32.38 feet
- 5/8" x 24" Iron rod/2" Alum. cap marked WITNESS MARKER S10°W 37.76 feet
- "+" chisled in large rock N82°W 10.48 feet
- Metal Survey Sign Post West 1.7 feet



NOTE: All bearings are magnetic bearings. All distances are measured with a steel tape. Distances to trees are to nail in side of tree.

Signed by William Lenca Date May 24, 1995  
 Surveyor's Michigan License No. 26461

SURVEY & RE-MONUMENTATION

DEC 01 1995