Approved by Menominee County
Land Survey Remonumentation
Peer Group Under Act 345 Of
P.A. Of 1990 On 10/26 1995
Chairman

LAND CORNER RECORDATION CERTIFICATE

Filing Requirement of Act 74, Mich. P.A. 1970

For corners in

MENOMINEE (County) Located In: Corner Code: 44

1. Public Land Survey		T 36N	R 26W	C-3
		T	R	
		T	R	
		T	R	
2. Property Controlling	S	T	R	
in Section	S	T	R	
3. Miscellaneous	S	T	R	
Property in Sec.	S	T	R	

RECEIVED FOR RECORD
95 NOV -8 AM 11:32
PAGE 350 BK 4
BARBARA HARRISON
REGISTER OF DEEDS
MENOMINEE COUNTY

Register of Deeds Stamp & File Number

4. Lot No. _____, Recorded Plat _____
5. Private Claims _____

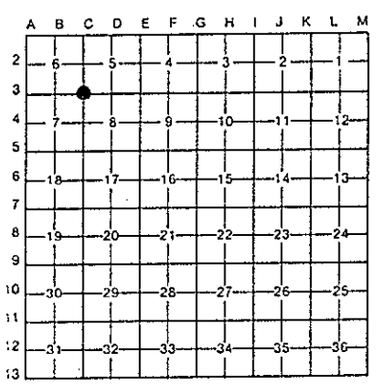

William Lenca, in a field survey on Mar 17, 19 95,

I hereby certify that under requirements of P.A. 74, Michigan P.A. of 1970, the corner points mentioned in lines 1 and 2 above were in conformance with regulations and rules therefore as required in the current manual of survey instructions of the United States Department of the Interior, Bureau of Land Management or by a decree of a Court of Law and/or that the corner points mentioned in lines 3, 4 and 5 above were in conformance with the rules of the Michigan Board of Land Surveyors or by a Decree of a Court of Law; established, re-established, monumented, re-monumented, recovered, found as expressed below:

NOTE: Not more than 4 corners, all in the same town and range, may be recorded on this certificate.

7. Description of original monument and accessories and/or subsequent restoration:

1848: Original Survey by Francis Coleman - B.T.'s - Cedar, 6" - N16°E - 25 lks; Cedar, 10" - S80°W - 28 lks. All original evidence has been destroyed by road improvements.

8. Description of corner evidence found and/or method applied in restoring or reestablishing corner:

We established this corner by splitting the fences on either side of an old East West Lane for North - South position, and in line with an ancient fence running North and South from this location for East - West position. The measured distance from this corner East to the centerline of a North-South County Road is 2663.4 feet compared to the GLO distance of 2666.4 feet. The measured distance from this corner West to an ancient N - S fence is 2642.86 feet compared to the GLO distance of 2640 feet. We accepted the corner thus arrived at as the best available evidence of the position of the original corner.

9. Description of monument for corner and accessories established to perpetuate locating the position of the corner:

Set 5/8"x 24" Iron Rod w/3 1/4" Alum. Cap stamped for corner 0.5' Below Grade in South Track of E-W Lane:

10" dia. Tamarack	N57°E	41.30 feet	Scr. NBT
9" dia. Tamarack	S40°E	23.28 feet	Scr. NBT
5" dia. Cedar	S51°W	49.39 feet	Scr. NBT
6" dia. Cedar	N30°W	61.25 feet	Scr. NBT
Metal Survey Sign Post	N04°E	12.4 feet	

STATE OF MICHIGAN
WILLIAM LENCA
LAND SURVEYOR
No. 26461
REGISTERED LAND SURVEYOR

NOTE: All bearings are magnetic bearings. All distances are measured with a steel tape. Distances to trees are to nail in side of tree.

Signed by William Lenca Date May 24, 1995

Surveyor's Michigan License No. 26461

FORM APPROVED BY MICHIGAN STATE BOARD OF LAND SURVEYORS, JAN. 28, 1971
REVISED MAY 14, 1975
REVISED JAN., 1983