PILLOS MARIATION

APR 0 6 1999

SECTION


LAND CORNER RECORDATION CERTIFICATE Filing Requirement of Act 74 Mich P A 1970

Land Survey Remonumentation Peer Group Under Act 345 Of				
1000 On			100 C	


Approved by Manaminee County

P.A. Of 1890 On .	12/14	!	كـ 199	2
Terene	Å	Wa	un	2.5
	Chairm	an		

	Filing Requirement of Act 7	74, Mich. P.A. 1970
For corners in MENOMINEE		GROVE 10
(County)	Located In: Corner Code #	
1. Public Land Survey	T_36NR_26W	
		Register of Deeds Stamp & File Number
4. Lot No, Reco 5. Private Claims	orded Plat	A B C D E F G H I J K L

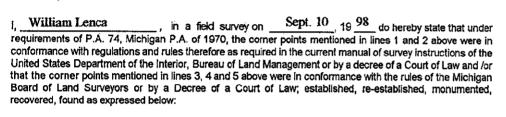

NOTE: Not more than 2 corners, all in the same town and range, may be recorded on this certificate.

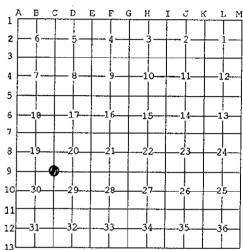

Lenca Land Wevetob

SEARO FUELO

- A. Description of original monument and accessories and/or subsequent restoration:
 - 1852: Original Survey by Francis Coleman B.T.'s Lynn, 12" N38°W 27 lks.; Hemlock, 12" S71°E 25 lks. All original evidence for this corner has been destroyed by county road improvements.
 - 1983: L.C.R.C. No. 578 by William Lenca, RLS 26461, states, "Set corner in line with centerline of county road east west and in line with ancient fence to the north." Set Railroad Spike in Asphalt Surface. TIES: Anchor Pole (tack) N05°W 46.82'; Power Pole (tack) S30°W 40.70'; Deep-1 (gray) S54°E 45.58'.
- B. Description of corner evidence found and/or method applied in restoring or reestablishing corner:

We found a railroad spike in a location as indicated in Land Corner Recordation Certificate Number 578. The centerline of a county road to the south is 6 feet East. This location has been used in previous surveys, fits well with other corners in the area, and is accepted as the best available evidence of the position of the original corner.

C. Description of monument for corner and accessories established to perpetuate locating the position of the corner.

Set 5/8" x 24" Iron Rod/3-1/4" dia. Alum. cap stamped for corner location in Monument Box:

NOTE: All bearings are magnetic bearings. All distances are measured with steel tape. Distances to trees are to nail in side of tree.

Signed by William Fines	Date	Dec. 10, 1998	
Surveyor's Michigan License No. 26461			