

Approved by Menominee County
Land Survey Remonumentation
Peer Group Under Act 345 Of

LAND CORNER RECORDATION CERTIFICATE
Filing Requirement of Act 74, Mich. P.A. 1970

P.A. Of 1990 On 12/12 1996
Mr. David RLS
Chairman

For corners in

MENOMINEE (County)	Located In:	Corner Code #
1. Public Land Survey	T <u>36N</u> R <u>26W</u>	<u>E02</u>
	T _____ R _____	_____
	T _____ R _____	_____
	T _____ R _____	_____
2. Property Controlling in Section	S _____ T _____	_____
	S _____ T _____	_____
3. Miscellaneous Property in Sec.	S _____ T _____	_____
	S _____ T _____	_____


REGISTERED FOR RECORD
 96 DEC 20 AM 9:31
 PAGE # 390, BK 4
 BARBARA MORANSON
 REGISTERED CLERK
 REGISTERED DEEDS

Register of Deeds Stamp & File Number

4. Lot No. _____, Recorded Plat _____
5. Private Claims _____

I, William Lenca, in a field survey on Nov. 06, 1996 do hereby state that under requirements of P.A. 74, Michigan P.A. of 1970, the corner points mentioned in lines 1 and 2 above were in conformance with regulations and rules therefore as required in the current manual of survey instructions of the United States Department of the Interior, Bureau of Land Management or by a decree of a Court of Law and/or that the corner points mentioned in lines 3, 4 and 5 above were in conformance with the rules of the Michigan Board of Land Surveyors or by a Decree of a Court of Law, established, re-established, monumented, recovered, found as expressed below:

NOTE: Not more than 2 corners, all in the same town and range, may be recorded on this certificate.

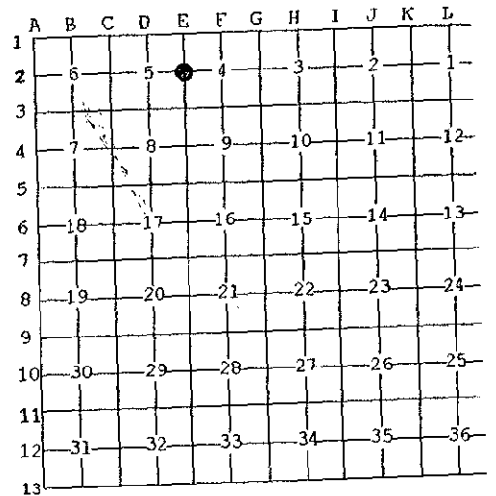

A. Description of original monument and accessories and/or subsequent restoration:

1852: Original Survey by Francis Coleman - B.T.'s - Cedar, 16" - N35°E - 39 lks; Cedar, 20" - S50°E - 39 lks. All original evidence for this corner has been destroyed by county road improvements.


B. Description of corner evidence found and/or method applied in restoring or reestablishing corner:

We set this corner on line and at a single proportional location between the Northeast Corner (E-1) and the Southeast Corner (E-3) of Section 5. This position falls 2 feet south of the centerline of an East - West County Road and fits very closely with GLO record measurments to corners North and South - GLO distance from E-2 to E-1 = 3016.2 feet; Measured distance = 3017.79 feet; GLO distance from E-2 to E-3 = 2640 feet; Measured distance = 2641.40 feet. We accepted this location as a careful and faithful reestablishment of the position of the original corner.

C. Description of monument for corner and accessories established to perpetuate locating the position of the corner:
Set 2" dia. Aluminum Pipe/3-1/4" dia. Alum cap stamped for corner location:

10" dia. Ironwood	N47°E	43.88 feet	Scr. NBT
10" dia. Ironwood	S51°E	41.30 feet	Scr. NBT
5" dia. Cedar	S41°W	22.57 feet	Scr. NBT
6" dia. Cedar	N38°W	51.91 feet	Scr. NBT
Metal Survey Sign Post	South	15.3 feet	

NOTE: All bearings are magnetic bearings. All distances are measured with steel tape. Distances to trees are to nail in side of tree.

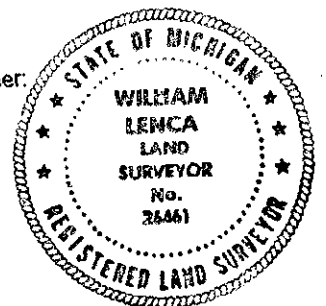

Signed by William Lenca
Surveyor's Michigan License No. 26461

Date Nov. 30, 1996