

APR 06 1999

SECTION

LAND CORNER RECORDATION CERTIFICATE
Filing Requirement of Act 74, Mich. P.A. 1970

Approved by Menominee County
Land Survey Remonumentation
Peer Group Under Act 345 Of

PA. Of 1990 On 12/14, 1998
Thomas S. Wain P.S.
Chairman

For corners in

<u>MENOMINEE</u> (County)	Located In:	Corner Code #
1. Public Land Survey	T <u>36N</u> R <u>26W</u>	<u>E-09</u>
	T ___ R ___	_____
	T ___ R ___	_____
	T ___ R ___	_____
2. Property Controlling in Section	S ___ T ___ R ___	_____
	S ___ T ___ R ___	_____
3. Miscellaneous Property in Sec.	S ___ T ___ R ___	_____
	S ___ T ___ R ___	_____

RECEIVED FOR RECORD
90 DEC 14 PM 3:22
PAGE # 678 Bk 3
BARBARA JOHNSON
REGISTER OF DEEDS
MENOMINEE, MI 49853

Register of Deeds Stamp & File Number

4. Lot No. _____, Recorded Plat _____
5. Private Claims _____

I, William Lenca, in a field survey on Sept. 01, 1998 do hereby state that under requirements of P.A. 74, Michigan P.A. of 1970, the corner points mentioned in lines 1 and 2 above were in conformance with regulations and rules therefore as required in the current manual of survey instructions of the United States Department of the Interior, Bureau of Land Management or by a decree of a Court of Law and/or that the corner points mentioned in lines 3, 4 and 5 above were in conformance with the rules of the Michigan Board of Land Surveyors or by a Decree of a Court of Law; established, re-established, monumented, recovered, found as expressed below:

NOTE: Not more than 2 corners, all in the same town and range, may be recorded on this certificate.

	A	B	C	D	E	F	G	H	I	J	K	L	M
1													
2	6		5		4		3		2		1		
3													
4	7		8		9		10		11		12		
5													
6	10		17		16		15		14		13		
7													
8	19		20		21		22		23		24		
9					●								
10	30		29		28		27		26		25		
11													
12	31		32		33		34		35		36		
13													

A. Description of original monument and accessories and/or subsequent restoration:

- 1852: Original Survey by Francis Coleman - B.T.'s - Hemlock, 20" - N12°W - 17 lks.; Hemlock, 6", N83°E, 12 lks. All original evidence for this corner has been destroyed by county road improvements.
- 1921: A.L. Hillis, Engineer, in Menominee Co. Rd Comm. Plan shows iron pin in c/1 of Co. Rd.
- 1993: L.C.R.C. No. 965 (Bk 3) by Paul Bressette, RLS 37270 - SEE BACK OF FORM.


B. Description of corner evidence found and/or method applied in restoring or reestablishing corner:

We found a W-1-B Berntsen Road Monument with a 4 inch diameter aluminum cap described as "Menominee County Mon." in L.C.R.C. No. 965 (Bk 3) and the 4 witnesses listed thereon. This position fits well with measurements to corners and occupations 1/2 mile North, South, East and West, and is accepted as the best available evidence of the position of the original corner.

C. Description of monument for corner and accessories established to perpetuate locating the position of the corner:

Accepted existing W-1-B Berntsen Road Monument stamped for corner location.

6" dia. Twin Cedar (Ex. B.T.)	N61°E	85.68 feet	
5/8" x 24" Iron Rod/2" dia. Alum. cap marked "WITNESS MARKER"	S39°W	52.67 feet	0.9' E. of Tel. Box
5/8" x 24" Iron Rod/2" dia. Alum. cap marked "WITNESS MARKER"	N49°W	62.07 feet	@ Survey Sign Post
Stop Sign	S17°E	63.40 feet	
Metal Survey Sign Post	East	0.90 feet	

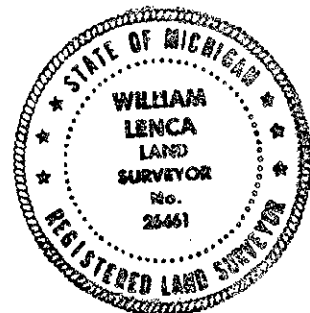

NOTE: All bearings are magnetic bearings. All distances are measured with steel tape. Distances to trees are to nail in side of tree.

Signed by William Lenca
Surveyor's Michigan License No. 26461

Date Dec. 10, 1998