PA OF 1990 On 12/30 1998

Mrs Davis PLS

2.DQ	06	1999	

, Recorded Plat


5. Private Claims

	rom.		1945	200	rs.	

		CORNER RECORDATION CE	(T) Chairman	
	Filing	Requirement of Act 74, Mich.	P.A. 1970	
For corners in				
MENOMINEE	Located In:	Corner Code #	P.A. 1970 ARBANA ARB	
(County)	Loodled III.	Comer Code #	FER OF OR	
1. Public Land Survey	T <u>36N</u> R_ T R_ T R_	26W E-11	R RECERII M 8: 5 FORRISO M 48858	
Property Controlling in Section Miscellaneous Property in Sec.	S TR_ S TR_ S TR_ S TR_		Register of Deeds Stamp & File Numbe	:

i, William Lenca	, in a field survey on _	Sep. 10 , 19	98_ do hereby state	that under
requirements of P.A. 74, Mich	igan P.A. of 1970, the corner	points mentione	d in lines 1 and 2 abo	ve were in
conformance with regulations a	nd rules therefore as required	in the current ma	nual of survey instruct	lions of the
United States Department of th	e Interior, Bureau of Land Ma	nagement or by a	decree of a Court of L	aw and /or
that the corner points mention				
Board of Land Surveyors or	by a Decree of a Court of	Law; established	d, re-established, mo	numented.
recovered, found as expressed	•	•		

NOTE: Not more than 2 corners, all in the same town and range, may be recorded

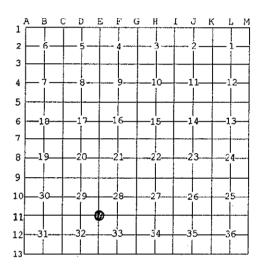


- A. Description of original monument and accessories and/or subsequent restoration:
 - Original Survey by Francis Coleman B.T.'s Tamarack, 6" N43°W 24 lks.; Cedar, 8" S05°E 25 lks. All original evidence for this corner has been destroyed by County Road improvements.
- B. Description of corner evidence found and/or method applied in restoring or reestablishing corner:

A concientious search of the most probable location for this corner produced no evidence of restoration, so the corner was re-set in the centerline of a North - South County Road, in line with the centerline of an old lane running East and with an ancient fence line running West. This location was accepted as the best available evidence of the position of the original corner.

C. Description of monument for corner and accessories established to perpetuate locating the position of the corner:

Set 5/8" x 24" Iron Rod/3-1/4" dia. Alum. cap stamped for corner location in Monument Box:

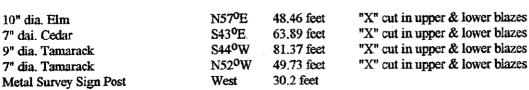

NOTE: All bearings are magnetic bearings. All distances are measured with steel tape. Distances to trees are to nail in side of tree.

Signed by William Janua	Date	Dec. 29, 1998
Surveyor's Michigan License No. 26461		

EUNARA OS