


Approved by Menominee County
 Land Survey Remonumentation
 Peer Group Under Act 345 Of
 P.A. of 1990 On 12/12 1996
Mr. Brown
 Chairman

LAND CORNER RECORDATION CERTIFICATE
 Filing Requirement of Act 74, Mich. P.A. 1970

For corners in

<u>MENOMINEE</u> (County)	Located In:	Corner Code #
1. Public Land Survey	T <u>36N</u> R <u>26W</u>	<u>L-3</u>
	T _____ R _____	_____
	T _____ R _____	_____
	T _____ R _____	_____
2. Property Controlling in Section	S _____ T _____ R _____	_____
	S _____ T _____ R _____	_____
3. Miscellaneous Property in Sec.	S _____ T _____ R _____	_____
	S _____ T _____ R _____	_____
4. Lot No. _____, Recorded Plat _____		
5. Private Claims _____		

RECORDED FOR RECORD
 06 DEC 20 AM 9:34
 CASE # 387, BK 4
 REGISTERED FOR RECORD
 REGISTER OF DEEDS STAMP & FILE NUMBER

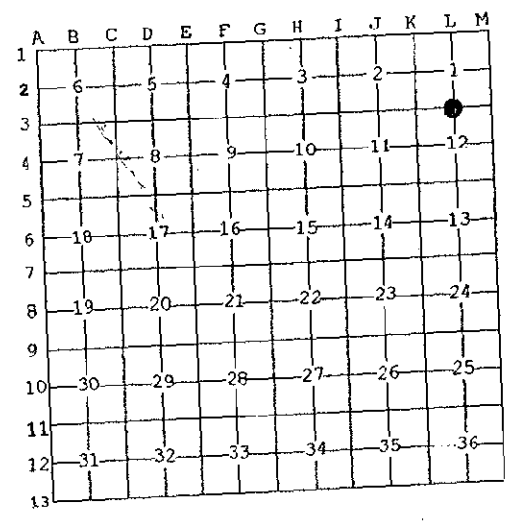

I, William Lenca, in a field survey on Oct. 02, 1996, do hereby state that under requirements of P.A. 74, Michigan P.A. of 1970, the corner points mentioned in lines 1 and 2 above were in conformance with regulations and rules therefore as required in the current manual of survey instructions of the United States Department of the Interior, Bureau of Land Management or by a decree of a Court of Law and/or that the corner points mentioned in lines 3, 4 and 5 above were in conformance with the rules of the Michigan Board of Land Surveyors or by a Decree of a Court of Law; established, re-established, monumented, recovered, found as expressed below:

NOTE: Not more than 2 corners, all in the same town and range, may be recorded on this certificate.

A. Description of original monument and accessories and/or subsequent restoration:
 1852: Original Survey by Francis Coleman - B.T.'s - Cedar, 10" - S31°E - 15 lks; Cedar, 12" - N40°W - 04 lks. All original evidence for this corner has been destroyed by fire and logging activities.

B. Description of corner evidence found and/or method applied in restoring or reestablishing corner:
 We located the single proportional position for this corner between the SW Corner and the SE Corner of Section 1, T36N-R26W, and searched this area for original evidence. We spoke with Mr. Roger Swanson, owner of the surrounding property for over 20 years, and he stated that he did not recall ever seeing a corner post or associated blazes in this location. We set the corner at the above mentioned proportional location and accepted this location as a careful and faithful reestablishment of the position of the original corner.

C. Description of monument for corner and accessories established to perpetuate locating the position of the corner:
 Set 2" dia. Aluminum Pipe/3-1/4" dia. Alum cap stamped for corner location:

10" dia. Cedar	N16°E	41.92 feet	Scr. NBT
9" dia. Cedar	S65°E	9.85 feet	Scr. NBT
9" dia. Cedar	S20°W	11.43 feet	Scr. NBT
9" dia. Cedar	N71°W	25.11 feet	Scr. NBT
Metal Survey Sign Post	South	0.9 feet	

NOTE: All bearings are magnetic bearings. All distances are measured with steel tape. Distances to trees are to nail in side of tree.

Signed by William Lenca Date Oct. 07, 1996
 Surveyor's Michigan License No. 26461