

APR 06 1998

SECTION

LAND CORNER RECORDATION CERTIFICATE  
Filing Requirement of Act 74, Mich. P.A. 1970

Approved by Menominee County  
Land Survey Remonumentation  
Four Group Under Act 345 Of  
P.A. OF 1986 On 6/26 1998  
Mr. Davis PLS  
Chairman

For corners in


MENOMINEE (County)	Located In:	Corner Code #
1. Public Land Survey	T <u>36</u> N R <u>27</u> W	<u>C-03</u>
	T _____ R _____	_____
	T _____ R _____	_____
	T _____ R _____	_____
2. Property Controlling in Section	S _____ T _____ R _____	_____
	S _____ T _____ R _____	_____
3. Miscellaneous Property in Sec.	S _____ T _____ R _____	_____
	S _____ T _____ R _____	_____

RECEIVED FOR RECORD  
98 DEC -4 PM 3:48  
PAGE # 652 BK 5  
BARBARA MORRISON  
REGISTER OF DEEDS  
MENOMINEE, MI 49858  
Register of Deeds Stamp & File Number

4. Lot No. \_\_\_\_\_, Recorded Plat \_\_\_\_\_  
5. Private Claims \_\_\_\_\_

I, William Lenca, in a field survey on June 03, 19 98 do hereby state that under requirements of P.A. 74, Michigan P.A. of 1970, the corner points mentioned in lines 1 and 2 above were in conformance with regulations and rules therefore as required in the current manual of survey instructions of the United States Department of the Interior, Bureau of Land Management or by a decree of a Court of Law and/or that the corner points mentioned in lines 3, 4 and 5 above were in conformance with the rules of the Michigan Board of Land Surveyors or by a Decree of a Court of Law; established, re-established, monumented, recovered, found as expressed below:

NOTE: Not more than 2 corners, all in the same town and range, may be recorded on this certificate.

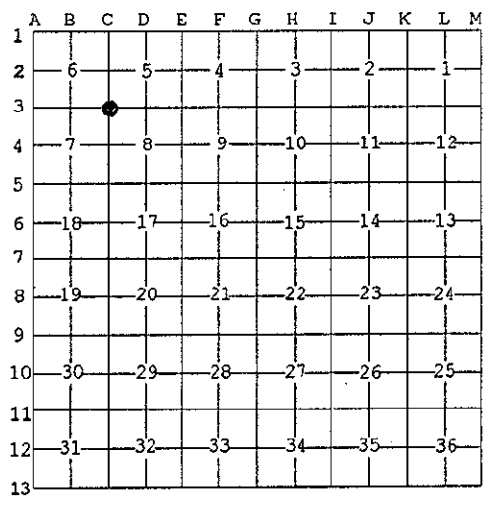

A. Description of original monument and accessories and/or subsequent restoration:

- 1852: Original Survey by Francis Coleman - B.T.'s - Cedar, 16" - N55°W - 29 lks.; Cedar, 10" - S35°E - 72 lks. All original evidence for this corner has been destroyed by logging activities.
- 1981: Land Corner Recordation Certificate Number 277 by David B. Babbitt states, "Set in centerline of roads east and south and in line with old fence west. No sign of O.B.T.'s. Measurements N-S and east are reasonable." Set 1" pipe with 4" Aluminum cap: 8" Cedar, S36°W, 97.5'; 8" Poplar, N85°W, 8.1'; 9" Twin Cedar, N19°E, 48.4'; 3" Cedar, S82°E, 79.3'.

B. Description of corner evidence found and/or method applied in restoring or reestablishing corner:

We found an existing 1" Iron Pipe with a 4" diameter Aluminum cap in a location as indicated in Land Corner Recordation Certificate Number 277 by David B. Babbitt. This location has been used for many years, fits existing lines of occupation, and is accepted as the best available evidence of the position of the original corner.

C. Description of monument for corner and accessories established to perpetuate locating the position of the corner:

Accepted existing 1" Iron Pipe with 4" diameter aluminum cap:

10" dia. Cedar	N07°E	88.24 feet	Scr. NBT
9" dia. Cedar	S82°E	79.62 feet	Ex. BT
4" dia. Tamarack	S31°W	85.45 feet	Scr. NBT
7" dia. Cedar	N88°W	56.55 feet	Scr. NBT
Metal Survey Sign Post	West	1.55 feet	



NOTE: All bearings are magnetic bearings. All distances are measured with steel tape. Distances to trees are to nail in side of tree.

Signed by William Lenca  
Surveyor's Michigan License No. 26461

Date June 25, 1998

652