

SURVEY & REMONUMENTATION

OCT 27 1999

SECTION

LAND CORNER RECORDATION CERTIFICATE
Filing Requirement of Act 74, Mich. P.A. 1970

Approved by Menominee County
Land Survey Remonumentation
Peer Group Under Act 345 Of
P.A. of 1990 On 10/11, 1999
Al Davis PLS
Chairman

For corners in

MENOMINEE (County)	Located In:	Corner Code #
1. Public Land Survey	T <u>35N</u> R <u>27W</u>	<u>C-01</u>
	T ___ R ___	_____
	T ___ R ___	_____
	T ___ R ___	_____
2. Property Controlling in Section	S ___ T ___ R ___	_____
	S ___ T ___ R ___	_____
3. Miscellaneous Property in Sec.	S ___ T ___ R ___	_____
	S ___ T ___ R ___	_____

RECEIVED FOR RECORD
99 OCT 15 PM 1:41
PAGE # 20 OF 6
BARBARA MORRISON
REGISTER OF DEEDS
MENOMINEE MI 49858
Register of Deeds Stamp & File Number

4. Lot No. _____, Recorded Plat _____
5. Private Claims _____

(SAME AS CORNER C-13 T36N - R27W)

I, William Lenca, in a field survey on July 26, 1999, do hereby state that under requirements of P.A. 74, Michigan P.A. of 1970, the corner points mentioned in lines 1 and 2 above were in conformance with regulations and rules therefore as required in the current manual of survey instructions of the United States Department of the Interior, Bureau of Land Management or by a decree of a Court of Law and/or that the corner points mentioned in lines 3, 4 and 5 above were in conformance with the rules of the Michigan Board of Land Surveyors or by a Decree of a Court of Law, established, re-established, monumented, recovered, found as expressed below:

1	A	B	C	D	E	F	G	H	I	J	K	L	M
2		6	5	4	3	2	1						
3													
4		7	8	9	10	11	12						
5													
6		10	17	16	15	14	13						
7													
8		19	20	21	22	23	24						
9													
10		30	29	28	27	26	25						
11													
12		31	32	33	34	35	36						
13													


NOTE: Not more than 2 corners, all in the same town and range, may be recorded on this certificate.

A. Description of original monument and accessories and/or subsequent restoration:

- 1847: Original Survey by John Mullett - B.T.'s - Hemlock, 18" - N25°E - 24 lks.; Beech, 16" - N25°W - 28 lks. All original evidence for this corner has been destroyed by County Road improvements.
- 1848: Sectional Subdivision by James H. Mullett - B.T.'s - Hemlock, 14" - S55°W - 13 lks.; Ironwood, 12" - S60°E - 24 lks. All original evidence for this corner has been destroyed County Road improvements.

B. Description of corner evidence found and/or method applied in restoring or reestablishing corner:

We found a P.K. Nail in the centerline of county roads running North - South - East and West. This position fits well with existing lines of occupation and with measurements to corners 1/2 mile East (2657.81 feet), 1/2 mile West (2682.88 feet) and 1/2 mile South (2579.38 feet), and is accepted as the best available evidence of the position of the original corner.

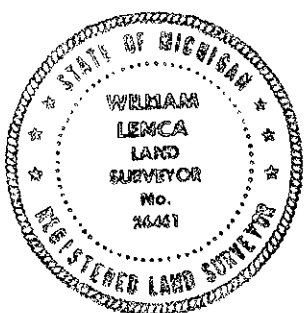

C. Description of monument for corner and accessories established to perpetuate locating the position of the corner:

Set 5/8" x 24" Iron Rod/3-1/4" dia. Alum. cap stamped for corner location in Monument Box:

5/8" x 24" Iron Rod/2" dia. Alum. cap marked "WITNESS MARKER"	N35°E	48.35 feet	1' East of Rd Sign
5/8" x 24" Iron Rod/2" dia. Alum. cap marked "WITNESS MARKER"	S38°E	39.53 feet	@ Survey Sign
5/8" x 24" Iron Rod/2" dia. Alum. cap marked "WITNESS MARKER"	S49°W	47.52 feet	1' West of Fc. Post
5/8" x 24" Iron Rod/2" dia. Alum. cap marked "WITNESS MARKER"	N47°W	46.17 feet	1' East of Power Pole
Metal Survey Sign Post	S38°E	41.25 feet	

NOTE: All bearings are magnetic bearings. All distances are measured with steel tape. Distances to trees are to nail in side of tree.

Signed by William Lenca
Surveyor's Michigan License No. 26461

Date Sep. 1, 1999