

LAND CORNER RECORDATION CERTIFICATE
Filing Requirement of Act 74, Mich. P.A. 1970

For corners in

Memominee (County) Located In: Corner Code: //
1. Public Land Survey T 36N R 28W H-9, H-11, I-9
2. Property Controlling in Section S T R
3. Miscellaneous Property in Sec. S T R

Register of Deeds Stamp & File Number

4. Lot No. , Recorded Plat
5. Private Claims

I, Paul R. Bressette, in a field survey on November 19 94 do hereby certify that under requirements of P.A. 74, Michigan P.A. of 1970, the corner points mentioned in lines 1 and 2 above were in conformance with regulations and rules therefore as required in the current manual of survey instructions of the United States Department of the Interior, Bureau of Land Management or by a decree of a Court of Law and/or that the corner points mentioned in lines 3, 4 and 5 above were in conformance with the rules of the Michigan Board of Land Surveyors or by a Decree of a Court of Law; established, re-established, monumented, re-monumented, recovered, found as expressed below:

NOTE: Not more than 4 corners, all in the same town and range, may be recorded on this certificate.

Grid table with columns A-M and rows 2-13. Contains numbers 1-36 and symbols at intersections.

A. Description of original monument and accessories and/or subsequent restoration:


- 9. Quarter Corner common to Sections 22 and 27. 1852: Francis Coleman, D.S. Set wood post witnessed by: Maple 6 N45E 65 lks.; W. Pine 16 S40W 64 lks.
-11. Quarter Corner common to Sections 27 and 34. 1852: Francis Coleman, D.S. Set wood post witnessed by: Y. Pine 18 S38E 45 lks.; Beech 10 N64W 30 lks.
-9. Section Corner common to Sections 22, 23, 26 and 27. 1961: Billy J. Buckler, RLS. Set 1" iron pipe w/ aluminum cap witnessed by: 8" Cedar S06W 19.5 lks.; 7" Cedar S68E 16.5 lks.; 10" W. Pine N01E 22 lks.

B. Description of corner evidence found and/or method applied in restoring or reestablishing corner:

- 9. No evidence of original survey or restoration found. Corner position re-established mid-point and on-line between the Northeast and Northwest corners of Section 27.
-11. No evidence of original survey or restoration found. Corner position re-established at the intersection of ancient fences east, west and south. Distance west to southwest section corner fits well. Distance east to stream (GLO-24.5 ch.-1617', meas.-1594') fits fair.
-9. Found monument and SE NBT as described. SW NBT is dead and down and NE NBT is gone. Rewitnessed monument as found.

C. Description of monument for corner and accessories established to perpetuate locating the position of the corner:

Table with 3 columns: DNR monument, H-11. DNR monument, H-9. DNR monument. Lists various trees and distances.

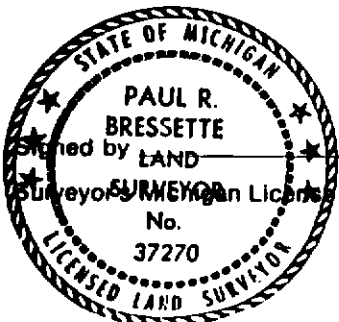

Paul R. Bressette Date 2-13-95

Surveyor's License No. 37270