

SURVEY & REMONUMENTATION

APR 06 1999

SECTION

LAND CORNER RECORDATION CERTIFICATE
Filing Requirement of Act 74, Mich. P.A. 1970

Approved by Menominee County
Land Survey Remonumentation
Peer Group Under Act 345 Of
P.A. Of 1990 On 12/14 1998
Thomas J. Wynn P.S.
Chairman

For corners in

MENOMINEE

(County)

Located In:

Corner Code #

1. Public Land Survey		T <u>36</u> N R <u>28</u> W	E-11
		T ___ R ___	_____
		T ___ R ___	_____
		T ___ R ___	_____
2. Property Controlling in Section	S ___	T ___ R ___	_____
	S ___	T ___ R ___	_____
3. Miscellaneous Property in Sec.	S ___	T ___ R ___	_____
	S ___	T ___ R ___	_____

RECEIVED FOR RECORD
99 DEC 14 PM 3:22
PAGE # 676 BK 5
BARBARA MORRISON
REGISTER OF DEEDS
MENOMINEE, MI 49855

Register of Deeds Stamp & File Number

4. Lot No. _____, Recorded Plat _____
5. Private Claims _____

I, William Lenca, in a field survey on July 08, 1998 do hereby state that under requirements of P.A. 74, Michigan P.A. of 1970, the corner points mentioned in lines 1 and 2 above were in conformance with regulations and rules therefore as required in the current manual of survey instructions of the United States Department of the Interior, Bureau of Land Management or by a decree of a Court of Law and/or that the corner points mentioned in lines 3, 4 and 5 above were in conformance with the rules of the Michigan Board of Land Surveyors or by a Decree of a Court of Law, established, re-established, monumented, recovered, found as expressed below:

NOTE: Not more than 2 corners, all in the same town and range, may be recorded on this certificate.

A	B	C	D	E	F	G	H	I	J	K	L	M
1												
2	6	5	4	3	2	1						
3												
4	7	8	9	10	11	12						
5												
6	18	17	16	15	14	13						
7												
8	19	20	21	22	23	24						
9												
10	30	29	28	27	26	25						
11												
12	31	32	33	34	35	36						
13												

A. Description of original monument and accessories and/or subsequent restoration:

- 1852: Original Survey by Francis Coleman - B.T.'s - Hemlock, 14" - N47°W - 1.12 lks.; Maple, 10" - S45°E - 25 lks. All original evidence for this corner has been destroyed by logging activities.
- 1957: L.C.R.C. No. 119 by Billy D. Buckler states, "Found 2-1/2" pipe with 3-1/2" brass cap set by Wisc. - Mi. Power Co. and 3/4" iron bar set by J.C. Iymer, Surveyor in 1927." Corner lies 4 chains north of road. Found Witnesses: W. Pine, 9" - S77°E - 29 lks.; R. Oak, 12" - S75°W - 16 lks.; W. Pine, 9" - N12°W - 5.5 lks.


B. Description of corner evidence found and/or method applied in restoring or reestablishing corner:

We found a 2-1/2" Iron Pipe with a 3-1/4" Alum. cap stamped "WIS. MICH. POWER CO." in a location as indicated in Land Corner Recordation Certificate Number 119. This position has been used by surveyors for over 70 years and is accepted as the best available evidence of the position of the original corner.

C. Description of monument for corner and accessories established to perpetuate locating the position of the corner:

Accepted existing 2-1/2" dia. Iron Pipe with 3-1/4" dia. Alum. cap:

12" dia. Oak	N45°E	18.16 feet	Scr. NBT
18" dia. White Pine	S41°E	28.14 feet	Scr. NBT
12" dia. White Pine	S28°W	19.99 feet	Scr. NBT
22" dia. White Pine	N89°W	47.33 feet	Scr. NBT
Metal Survey Sign Post	North	0.9 feet	

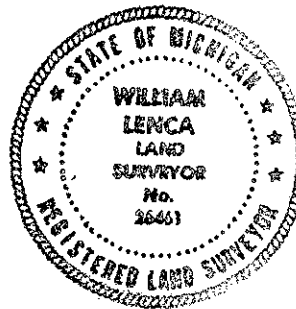

NOTE: All bearings are magnetic bearings. All distances are measured with steel tape. Distances to trees are to nail in side of tree.

Signed by William Lenca
Surveyor's Michigan License No. 26461

Date Oct. 05, 1998

676