SURVEY &
REMONUMENTATION

OCT 27 1999

Approved by Menominee County
Land Survey Remonumentation
Peer Group Under Act 345 Of
P.A. Of 1990 On 10/11 1999
Chairman

LAND CORNER RECORDATION CERTIFICATE
Filing Requirement of Act 74, Mich. P.A. 1970

For corners in SECTION

MENOMINEE (County) Located In: Corner Code #

1. Public Land Survey		T 36N	R 28W	H-13
		T___	R___	
		T___	R___	
		T___	R___	
2. Property Controlling	S___	T___	R___	
in Section	S___	T___	R___	
3. Miscellaneous	S___	T___	R___	
Property in Sec.	S___	T___	R___	

RECEIVED FOR RECORD
99 OCT 15 PM 1:40
BARBARA MORRISON
REGISTER OF DEEDS
MENOMINEE, MI 49858
PAGE # 08 Bk 6

Register of Deeds Stamp & File Number

4. Lot No. _____, Recorded Plat _____
5. Private Claims _____

SAME AS CORNER H-1, T35N-R28W

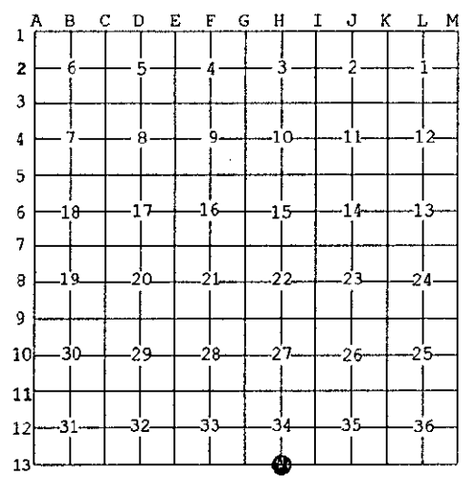

I, William Lenca, in a field survey on Feb., 1999 do hereby state that under requirements of P.A. 74, Michigan P.A. of 1970, the corner points mentioned in lines 1 and 2 above were in conformance with regulations and rules therefore as required in the current manual of survey instructions of the United States Department of the Interior, Bureau of Land Management or by a decree of a Court of Law and /or that the corner points mentioned in lines 3, 4 and 5 above were in conformance with the rules of the Michigan Board of Land Surveyors or by a Decree of a Court of Law; established, re-established, monumented, recovered, found as expressed below:

NOTE: Not more than 2 corners, all in the same town and range, may be recorded on this certificate.

A. Description of original monument and accessories and/or subsequent restoration:

1852: Original Survey by Francis Coleman - B.T.'s - Beech, 14" - N25°E - 09 lks; W. Pine, 30" - N53°W - 21 lks. Remnants of W. Pine B.T. still visible.

1981: L.C.R.C. No. 319 by George B. Wilson, RLS 17607, - Found W. Pine stump (orig BT). Found Old post hole - orig. stake. Set HDR 1 Berntsen Monument. TIES: Deep-1 Orange - 30' North; Deep-1 Purple - 30' East.

B. Description of corner evidence found and/or method applied in restoring or reestablishing corner:

We found a 3/4 inch diameter aluminum rod with 3-1/4 inch diameter aluminum cap along with the 2 Deep-1 magnets as described in L.C.R.C. No. 319 (see part "A"). Since this corner was set from original evidence, we accepted the existing monument as a careful and faithful perpetuation of the position of the original corner.

C. Description of monument for corner and accessories established to perpetuate locating the position of the corner:

STATE OF MICHIGAN
WILLIAM LENCA
LAND SURVEYOR
No. 26461
REGISTERED LAND SURVEYOR

Accepted existing 3/4" aluminum rod/3-1/4" dia. Alum. cap stamped for corner:

8" dia. Cedar	N75°E	61.34 feet	Scr. NBT
14" dia. Maple	S05°W	55.61 feet	Scr. NBT
10" dia. Tamarack	N08°W	62.50 feet	Scr. NBT
Deep-1 Magnet	North	30.0 feet	
Metal Survey Sign Post	West	1.0 feet	

NOTE: All bearings are magnetic bearings. All distances are measured with steel tape. Distances to trees are to nail in side of tree.

Signed by W. William Lenca Date Sep. 15, 1999

Surveyor's Michigan License No. 26461

FORM APPROVED BY MICHIGAN STATE BOARD OF PROFESSIONAL SURVEYORS, JAN. 28, 1971
REVISED MAY 14,1975
REVISED JAN., 1983
REVISED OCT., 1995

8