

Approved by Menominee County
 Land Survey Remonumentation
 Peer Group Under Act 345 Of
 P.A. of 1990 On 9/25, 19996
Alfred Davis RLS
 Chairman

LAND CORNER RECORDATION CERTIFICATE
 Filing Requirement of Act 74, Mich. P.A. 1970

For corners in
MENOMINEE
 (County)

Located In:	Corner Code #
T36N R 28W	107
T R	
T R	
T R	
S T R	
S T R	
S T R	
S T R	

1. Public Land Survey

2. Property Controlling in Section


3. Miscellaneous Property in Sec.

4. Lot No. _____, Recorded Plat _____

5. Private Claims _____

RECEIVED FOR RECORDING
 96 OCT - 7 PM 3:25
 PAGE # 351 BK 4
 BARBARA MORRISON
 REGISTER OF DEEDS
 REGISTERED OFFICE

Register of Deeds Stamp & File Number

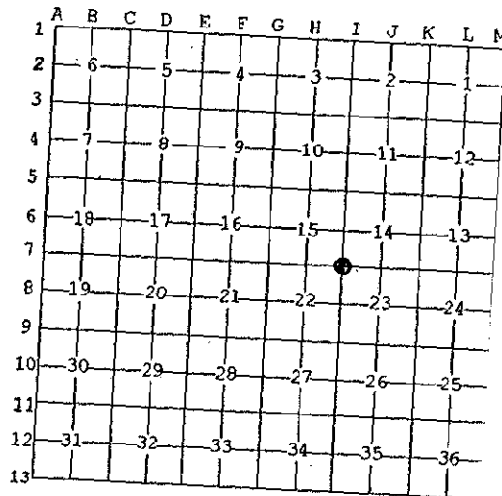

I, William Lenca, in a field survey on June 25, 1996 do hereby state that under requirements of P.A. 74, Michigan P.A. of 1970, the corner points mentioned in lines 1 and 2 above were in conformance with regulations and rules therefore as required in the current manual of survey instructions of the United States Department of the Interior, Bureau of Land Management or by a decree of a Court of Law and/or that the corner points mentioned in lines 3, 4 and 5 above were in conformance with the rules of the Michigan Board of Land Surveyors or by a Decree of a Court of Law, established, re-established, monumented, recovered, found as expressed below:

NOTE: Not more than 2 corners, all in the same town and range, may be recorded on this certificate.

A. Description of original monument and accessories and/or subsequent restoration:

1852: Original Survey by Francis Coleman - B.T.'s - Beech, 8" - N21°W - 53 lks (not evident); Y. Pine, 22" - S44°E - 37 lks (found stump with lower blaze visible).

B. Description of corner evidence found and/or method applied in restoring or reestablishing corner:

We established a search area for this corner by doubling the distance between the SE Corner and the S1/4 Corner for the East - West position. We then used a proration of our measured distances for N - S miles in this area as compared to GLO record distances. We applied this proration to the GLO record for the West Line of Section 14 and used this for our N - S position. The position thus established put us almost in an exact location fitting an old Pine Stump with lower blaze still visible. We set the corner at a bearing of N44°W and a distance of 32 links (21.1 feet) from the old Pine Stump, accepted this location as a careful and faithful perpetuation of the position of the original corner.

C. Description of monument for corner and accessories established to perpetuate locating the position of the corner:
 Set 2" dia. Aluminum Pipe/3-1/4" dia. Alum cap stamped for corner location:

5" dia. Maple	N31°E	65.84 feet	Scr. NBT
8" dia. Maple	S63°E	38.07 feet	Scr. NBT
12" dia. Maple	S23°W	75.54 feet	Scr. NBT
9" dia. Maple	N75°W	84.97 feet	Scr. NBT
Metal Survey Sign Post	North	1.05 feet	

NOTE: All bearings are magnetic bearings. All distances are measured with steel tape. Distances to trees are to nail in side of tree.

Signed by William Lenca
 Surveyor's Michigan License No. 26461

Date July 06, 1996

