

Approved by Menominee County  
 Land Survey Reestablishment  
 Peer Group Under Act 205 of  
 P.A. of 1990 On 9/25, 1996  
McDermis RLS  
 Chairman

LAND CORNER RECORDATION CERTIFICATE  
 Filing Requirement of Act 74, Mich. P.A. 1970


For corners in

MENOMINEE (County)	Located In:	Corner Code #
1. Public Land Survey	T <u>36</u> N R <u>28</u> W	<u>K07</u>
	T R	
	T R	
	T R	
2. Property Controlling in Section	S T R	
	S T R	
3. Miscellaneous Property in Sec.	S T R	
	S T R	

REGISTERED FOR RECORD  
 96 OCT - 7 PM 3:25  
 PAGE # 354 BK 4  
 BARBARA MORRISON  
 REGISTER OF DEEDS  
 MENOMINEE COUNTY, MICHIGAN  
 Register of Deeds Stamp & File Number

4. Lot No. \_\_\_\_\_, Recorded Plat \_\_\_\_\_  
 5. Private Claims \_\_\_\_\_

I, William Lenca, in a field survey on July 02, 1996 do hereby state that under requirements of P.A. 74, Michigan P.A. of 1970, the corner points mentioned in lines 1 and 2 above were in conformance with regulations and rules therefore as required in the current manual of survey instructions of the United States Department of the Interior, Bureau of Land Management or by a decree of a Court of Law and /or that the corner points mentioned in lines 3, 4 and 5 above were in conformance with the rules of the Michigan Board of Land Surveyors or by a Decree of a Court of Law; established, re-established, monumented, recovered, found as expressed below:

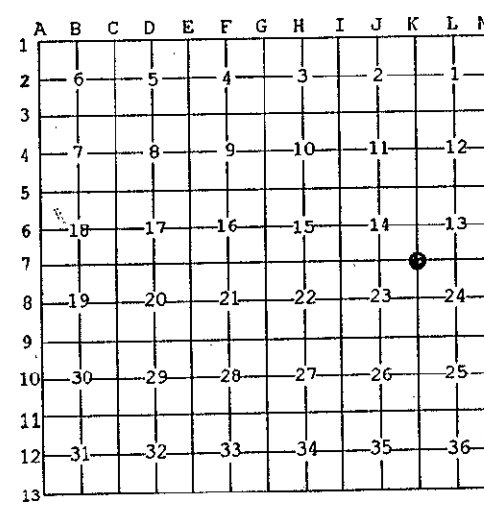

NOTE: Not more than 2 corners, all in the same town and range, may be recorded on this certificate.

A. Description of original monument and accessories and/or subsequent restoration:

1852: Original Survey by Francis Coleman - B.T.'s - Sugar, 18" - N48°E - 34 lks; Sugar, 16" - S64°W - 30 lks. All original evidence for this corner has been destroyed by county road improvements.

B. Description of corner evidence found and/or method applied in restoring or reestablishing corner:

We recovered a 1 inch diameter iron pipe, set by unknown person, in the centerline of county roads running North - South and West, and in line with an old fence line running East. This corner appears to have been in existence for several years and is accepted as the best available evidence of the position of the original corner.



C. Description of monument for corner and accessories established to perpetuate locating the position of the corner:  
 Set 2" dia. Aluminum Pipe/3-1/4" dia. Alum cap stamped for corner location:

5/8" x 24" Iron Rod/2" dia. Alum. cap marked "WITNESS MARKER"	N59°E	29.40 feet	1' W. of 8" wood gate post
8" dia. Ironwood	S42°E	74.98 feet	Scr. NBT
5/8" x 24" Iron Rod/2" dia. Alum. cap marked "WITNESS MARKER"	S47°W	31.85 feet	1' E. of Co. Rd. Sign
12" dia. White Ash	N57°W	93.20 feet	Scr. NBT
Metal Survey Sign Post	East	25.4 feet	

NOTE: All bearings are magnetic bearings. All distances are measured with steel tape. Distances to trees are to nail in side of tree.

July 06, 1996

Signed by William Lenca  
 Surveyor's Michigan License No. 26461

Date \_\_\_\_\_

354