LAND CORNER RECORDATION CERTIFICATE

Filing Requirement of Act 74, Mich. P.A. 1970 as Amended

For corners in

Menominee (County) Located In: Corner Code #

1. Public Land Survey T ____ R ____ ____
   T ____ R ____ ____
   T ____ R ____ ____
2. Property Controlling in Section S 13 T 37N R 25W 10
   S 14 T 37N R 25W 02
   S ____ T ____ R ____ ____
3. Miscellaneous Property in Sec. S ____ T ____ R ____ ____
   S ____ T ____ R ____ ____
4. Lot No. ____, Recorded Plat ____
5. Private Claims

Register of Deeds Stamp & File Number

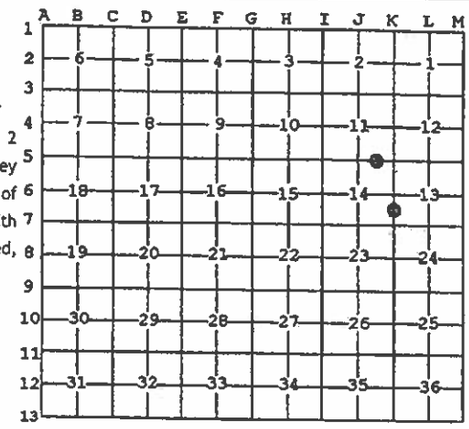

I, Jeremy J. Pipp, in a field survey on 2/24/2014 2/25/2014 do hereby state that under requirements of P.A. 74, Michigan P.A. of 1970, the corner points mentioned in lines 1 and 2 above were in conformance with regulations and rules therefore as required in the current manual of survey instructions of the United States Department of the Interior, Bureau of Land Management or by a decree of a Court of Law and /or that the corner points mentioned in lines 3, 4 and 5 above were in conformance with the rules of the Michigan Board of Land Surveyors or by a Decree of a Court of Law; established, re-established, monumented, recovered, found as expressed below:

NOTE: **Not more than 2 corners, all in the same town and range, may be recorded on this certificate.**

A. Description of original monument and accessories and/or subsequent restoration:

(10) South One-Sixteenth corner common to Sections 13 and 14. Not set in original survey. Found 5/8" smooth Iron Bar marking position, set by unknown persons.

(02) East One-Sixteenth corner common to Sections 11 and 14. Not set in original survey, no evidence of subsequent establishment.

B. Description of corner evidence found and/or method applied in restoring or reestablishing corner:

(10) Accepted above described monument as marking Corner position; checks well for position mid-point and on-line between the West One-Quarter corner and the Southwest corner of Section 13. Set MDNR monument over existing monument.

(02) Corner position established mid-point and on-line between the North One-Quarter corner and the Northeast corner of Section 14.

C. Description of monument for corner and accessories established to perpetuate locating the position of the corner:

(10) DNR monument

13" W. Pine	N52E	19.00'	(1/16S,BT)
4" Cedar	S74E	15.12'	(1/16S,BT)
6" Cedar	S35W	11.00'	(1/16S,BT)
8" Cedar	N89W	9.95'	(1/16S,BT)

All trees are blazed, scribed, and painted. Measurements are to nail in side of tree, bearings are magnetic.

(02) DNR monument

12" Cedar	N88E	11.73'	(1/16S,BT)
6" Cedar	S10E	16.05'	(1/16S,BT)
7" Cedar	S81W	13.52'	(1/16S,BT)
7" Cedar	N51W	30.38'	(1/16S,BT)

All trees are blazed, scribed, and painted. Measurements are to nail in side of tree, bearings are magnetic.

Signed by Jeremy J. Pipp Date July 9, 2014

Surveyor's Michigan License No. 50447

STATE OF MICHIGAN LICENSED PROFESSIONAL SURVEYOR JEREMY J. PIPP PROFESSIONAL SURVEYOR No. 50447

For the Michigan Department of Natural Resources, Forest Resources Division

20314

20315

FORM APPROVED BY MICHIGAN STATE BOARD OF PROFESSIONAL SURVEYORS, JAN. 28, 1971
Revised May 14, 1975
Revised Jan., 1983
Revised Oct., 1995