

P.A. of 1990 On 12/20 199 95
William Lenca
Chairman

LAND CORNER RECORDATION CERTIFICATE
Filing Requirement of Act 74, Mich. P.A. 1970

For corners in
MENOMINEE
(County)

Located In: 37N 26W Corner Code: M-5

| | | | | | |
|------------------------------------|---|-----------|---|-----------|--------------|
| 1. Public Land Survey | T | _____ | R | _____ | _____ |
| | T | _____ | R | _____ | _____ |
| | T | <u>37</u> | R | <u>25</u> | <u>A-5</u> ✓ |
| | T | _____ | R | _____ | _____ |
| 2. Property Controlling in Section | S | _____ | T | _____ | _____ |
| | S | _____ | T | _____ | _____ |
| 3. Miscellaneous Property in Sec. | S | _____ | T | _____ | _____ |
| | S | _____ | T | _____ | _____ |

RECEIVED FOR RECORD
95 DEC 27 PM 3:32
PAGE 312 BK-1
BARBARA ANDERSON
REGISTERED PROFESSIONAL
MENOMINEE COUNTY
Register of Deeds Stamp & File Number

4. Lot No. _____, Recorded Plat _____
5. Private Claims
(SAMES AS A-5 T37N-R25W)

| | | | | | | | | | | | | | |
|----|----|----|----|----|----|----|---|---|---|---|---|---|---|
| | A | B | C | D | E | F | G | H | I | J | K | L | M |
| 2 | 6 | 5 | 4 | 3 | 2 | 1 | | | | | | | |
| 3 | | | | | | | | | | | | | |
| 4 | 7 | 8 | 9 | 10 | 11 | 12 | | | | | | | |
| 5 | | | | | | | | | | | | | |
| 6 | 18 | 17 | 16 | 15 | 14 | 13 | | | | | | | |
| 7 | | | | | | | | | | | | | |
| 8 | 19 | 20 | 21 | 22 | 23 | 24 | | | | | | | |
| 9 | | | | | | | | | | | | | |
| 10 | 30 | 29 | 28 | 27 | 26 | 25 | | | | | | | |
| 11 | | | | | | | | | | | | | |
| 12 | 31 | 32 | 33 | 34 | 35 | 36 | | | | | | | |
| 13 | | | | | | | | | | | | | |


I, William Lenca, in a field survey on July 31, 19 95, do hereby certify that under requirements of P.A. 74, Michigan P.A. of 1970, the corner points mentioned in lines 1 and 2 above were in conformance with regulations and rules therefore as required in the current manual of survey instructions of the United States Department of the Interior, Bureau of Land Management or by a decree of a Court of Law and/or that the corner points mentioned in lines 3, 4 and 5 above were in conformance with the rules of the Michigan Board of Land Surveyors or by a Decree of a Court of Law; established, re-established, monumented, re-monumented, recovered, found as expressed below:

NOTE: Not more than 4 corners, all in the same town and range, may be recorded on this certificate.

- A. Description of original monument and accessories and/or subsequent restoration:
- 1848: Original Survey by James H. Mullett - B.T.'s - Cedar, 12" - S60°W - 15 lks; Cedar, 12" - N62°W - 34 lks. All original evidence has been destroyed by county road improvements.
 - 1899: Survey by Albert Hass, County Surveyor, shows subdivision of Section 7, T37N-R25W. His record states that the original corner was found, bearing trees standing. No new monument or witnesses are described.
 - 1982: Plat of Survey by William Lenca, RLS No. 26461, shows this corner as it relates to other corners in Section 7, T37N-R25W. The corner monument is described as a 3/4" x 18" iron pipe with identification cap set over angle iron found 2' below road surface.

B. Description of corner evidence found and/or method applied in restoring or reestablishing corner:

In a 1995 Survey in Section 12, T37N-R26W, we found a 3/4" x 18" iron pipe set over an existing angle iron. The corner position falls in the centerline of county roads East - West and North. The distance from this corner East to an ancient fence line matches very closely with record measurements: GLO & Hass' 1899 Survey = 36.72 chains or 2423.5 feet. Our present measurement = 2422.43 feet. This corner fits well with existing lines of occupation, has been used by local surveyors for at least 13 years, and is accepted as the best available evidence of the position of the original corner.

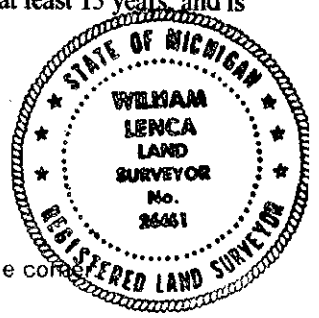

- C. Description of monument for corner and accessories established to perpetuate locating the position of the corner:
- Set 2" dia. Aluminum Pipe/3-1/4" dia. Alum cap stamped for corner location:
- | | | | |
|---|-------|------------|---------------------|
| 20" dia. Beech | N53°E | 99.71 feet | Scr. NBT |
| 12" dia. Apple | S45°E | 87.05 feet | |
| 5/8" x 24" Iron Rod/2" dia. Alum. cap marked "WITNESS MARKER" | S40°W | 36.59 feet | |
| 5/8" x 24" Iron Rod/2" dia. Alum. cap marked "WITNESS MARKER" | N41°W | 54.81 feet | 2.5' NW of Tel. Box |
| Metal Survey Sign Post | N41°W | 55.1 feet | |

NOTE: All bearings are magnetic bearings. All distances are measured with a steel tape. Distances to trees are to nail in side of tree.

Signed by William Lenca Date Nov. 17, 1995
Surveyor's Michigan License No. 26461

312