Approved by Menominee County
Land Survey Remonumentation
Peer Group Under Act 345 Of
P.A. Of 1990 On 12/27, 1996
Chairman

LAND CORNER RECORDATION CERTIFICATE
Filing Requirement of Act 74, Mich. P.A. 1970

For corners in

MENOMINEE (County)

	Located In:	Corner Code #
1. Public Land Survey	T37N R25W	C13
	T___ R___	
	T___ R___	
	T___ R___	
2. Property Controlling	S___ T___ R___	
In Section	S___ T___ R___	
3. Miscellaneous	S___ T___ R___	
Property in Sec.	S___ T___ R___	

Register of Deeds Stamp & File Number

96 DEC 30 PM 9:08
456 BK 5
BARBARA MORRISON
REGISTER OF DEEDS

4. Lot No. _____, Recorded Plat _____
5. Private Claims _____

SAME AS CORNER C-1, T36N-R25W

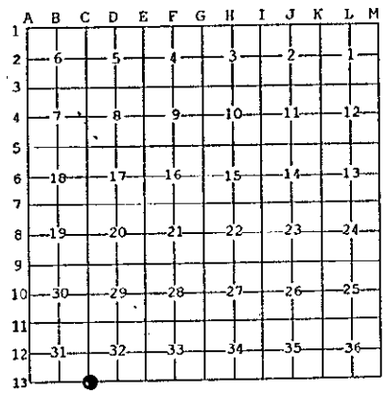

I, William Lenca, in a field survey on Sep 05, 19 96 do hereby state that under requirements of P.A. 74, Michigan P.A. of 1970, the corner points mentioned in lines 1 and 2 above were in conformance with regulations and rules therefore as required in the current manual of survey instructions of the United States Department of the Interior, Bureau of Land Management or by a decree of a Court of Law and /or that the corner points mentioned in lines 3, 4 and 5 above were in conformance with the rules of the Michigan Board of Land Surveyors or by a Decree of a Court of Law; established, re-established, monumented, recovered, found as expressed below:

NOTE: Not more than 2 corners, all in the same town and range, may be recorded on this certificate.

A. Description of original monument and accessories and/or subsequent restoration:

1847: Original Survey by James H. Mullett - B.T.'s - Sugar Maple, 14" - N09°E - 09 lks.; Hemlock, 17" - N75°W - 20 lks. All original evidence for this corner has been destroyed by logging activities.

B. Description of corner evidence found and/or method applied in restoring or reestablishing corner:

We determined the single proportional location of this corner between the S1/4 Corner (D-13) of Section 32 and the SW Corner (A-13) of Section 31, T37N-R25W. We searched this area and found no evidence of the original corner or of subsequent restoration. Our corner location fell 11.5' North and 10' East of an existing fence corner. Local residents stated that this fence was constructed in approximately 1960, and there was no corner evidence at the fence corner location. We therefore accepted the single proportional location as a careful and faithful reestablishment of the position of the original corner.

C. Description of monument for corner and accessories established to perpetuate locating the position of the corner:
Set 2" dia. Aluminum Pipe/3-1/4" dia. Alum. cap stamped for corner location:

STATE OF MICHIGAN
WILLIAM LENCA
LAND SURVEYOR
No. 26461
REGISTERED LAND SURVEYOR

8" dia. Maple	N60°E	66.49 feet	Scr. NBT
10" dia. Maple	S26°E	40.90 feet	Scr. NBT
8" dia. Balsam	S72°W	16.99 feet	Scr. NBT
12" dia. Maple	N17°W	19.76 feet	Scr. NBT
Metal Survey Sign Post	N80°W	0.90 feet	

NOTE: All bearings are magnetic bearings. All distances are measured with steel tape. Distances to trees are to nail in side of tree.

Signed by William Lenca
Date Dec. 19, 1996
Surveyor's Michigan License No. 26461

FORM APPROVED BY MICHIGAN STATE BOARD OF PROFESSIONAL SURVEYORS, JAN. 28, 1971
REVISED MAY 14,1975
REVISED JAN., 1983
REVISED OCT., 1995

456