

**SURVEY &
REMONUMENTATION**

MAY 28 1997

COMMISSION

LAND CORNER RECORDATION CERTIFICATE
Filing Requirement of Act 74, Mich. P.A. 1970

Approved by Menominee County
Land Survey Remonumentation
Peer Group Under Act 345 Of
P.A. Of 1990 On 12/27 1996
McDavid PLS
Chairman


For corners in
MENOMINEE
(County)

Located In: _____ Corner Code # _____

| | | |
|------------------------------------|-----------------------------|-------|
| 1. Public Land Survey | T <u>37</u> N R <u>25</u> W | D03 |
| | T _____ R _____ | _____ |
| | T _____ R _____ | _____ |
| | T _____ R _____ | _____ |
| 2. Property Controlling in Section | S _____ T _____ R _____ | _____ |
| | S _____ T _____ R _____ | _____ |
| 3. Miscellaneous Property in Sec. | S _____ T _____ R _____ | _____ |
| | S _____ T _____ R _____ | _____ |

RECEIVED FOR RECORD
97 JAN 17 AM 9 45
PAGE # 482 BK 5-
BARBARA MORRISON
REGISTER OF DEEDS
MENOMINEE, MI 49858
Register of Deeds Stamp & File Number

4. Lot No. _____, Recorded Plat _____
5. Private Claims _____

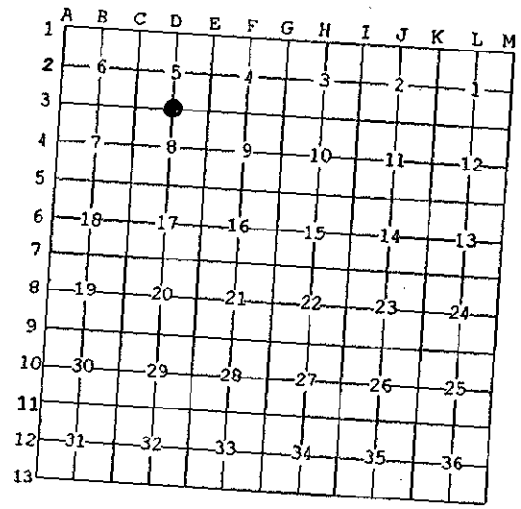

I, William Lenca, in a field survey on Jul. 24, 1996 do hereby state that under requirements of P.A. 74, Michigan P.A. of 1970, the corner points mentioned in lines 1 and 2 above were in conformance with regulations and rules therefore as required in the current manual of survey instructions of the United States Department of the Interior, Bureau of Land Management or by a decree of a Court of Law and for that the corner points mentioned in lines 3, 4 and 5 above were in conformance with the rules of the Michigan Board of Land Surveyors or by a Decree of a Court of Law; established, re-established, monumented, recovered, found as expressed below:

NOTE: Not more than 2 corners, all in the same town and range, may be recorded on this certificate.

A. Description of original monument and accessories and/or subsequent restoration:

1852: Original Survey by George Adair - B.T.'s - Birch, 10" - S11°W - 05 lks.; Cedar, 30" - N34°E - 19 lks. All original evidence for this corner has been destroyed by logging activities.

B. Description of corner evidence found and/or method applied in restoring or reestablishing corner:

We located the single proportional location for this corner between the Southwest Corner (C-3) and the Southeast Corner (E-3) of Section 5, T37N-R25W, and searched the area for evidence. Finding none, we accepted the single proportional location as a careful and faithful reestablishment of the position of the original corner.

C. Description of monument for corner and accessories established to perpetuate locating the position of the corner:
Set 2" dia. Aluminum Pipe/3-1/4" dia. Alum. cap stamped for corner location:

| | | | |
|------------------------|-------|------------|----------|
| 9" dia. Cedar | N22°E | 35.34 feet | Scr. NBT |
| 9" dia. Cedar | S75°E | 27.71 feet | Scr. NBT |
| 6" dia. Cedar | S10°W | 76.43 feet | Scr. NBT |
| 15" dia. White Spruce | N67°W | 12.34 feet | Scr. NBT |
| Metal Survey Sign Post | North | 1.20 feet | |



NOTE: All bearings are magnetic bearings. All distances are measured with steel tape. Distances to trees are to nail in side of tree.

Signed by William Lenca Date Dec. 20, 1996
Surveyor's Michigan License No. 26461