

LAND CORNER RECORDATION CERTIFICATE
Filing Requirement of Act 74, Mich. P.A. 1970

Mr. David RLS
Chairman

For corners in

MENOMINEE
(County)

Located In:

Corner Code #

1. Public Land Survey

T37N R 25W E7

T R

T R

T R

2. Property Controlling
in Section

S T R

S T R

3. Miscellaneous
Property in Sec.

S T R

S T R


95 DEC 27 PM 3:31
RECEIVED FOR RECORD
PAGE # 299 584
BARBARA JOHNSON
REGISTERED PROFESSIONAL
MENOMINEE COUNTY

Register of Deeds Stamp & File Number

4. Lot No. _____, Recorded Plat _____
5. Private Claims _____

I, William Lenca, in a field survey on Nov 06, 19 95 do hereby state that under requirements of P.A. 74, Michigan P.A. of 1970, the corner points mentioned in lines 1 and 2 above were in conformance with regulations and rules therefore as required in the current manual of survey instructions of the United States Department of the Interior, Bureau of Land Management or by a decree of a Court of Law and /or that the corner points mentioned in lines 3, 4 and 5 above were in conformance with the rules of the Michigan Board of Land Surveyors or by a Decree of a Court of Law; established, re-established, monumented, recovered, found as expressed below:

NOTE: Not more than 2 corners, all in the same town and range, may be recorded on this certificate.

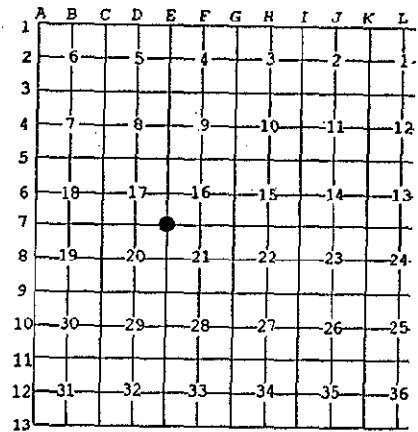

A. Description of original monument and accessories and/or subsequent restoration:

- 1852: Original Survey by George Adair - B.T.'s - Hemlock, 16" - N39.5°E - 26 lks (destroyed by farm clearing); Cedar, 12" - S60°W - 32 lks (found decayed stump).
- 1982: L.C.R.C. No. 526 by George B. Wilson, RLS No 17607, states that he found the stump of Cedar Tree with mark of blaze. He set a "HDR Monument" at corner. TIES: Deep-1 - 2 feet North and 2 feet East.

B. Description of corner evidence found and/or method applied in restoring or reestablishing corner:

In our 1995 Remonumentation Survey in T37N-R25W, we recovered a 3/4 inch diameter aluminum rod with 3-1/4 inch diameter aluminum cap marked "MENOMINEE COUNTY SURVEY CORNER" (Berntsen "HDR" Monument) in a newer fence line. We also found the stump of the 12" Cedar Original Bearing Tree - now a decayed stump approximately 18 inch in diameter. We were unable to identify the Original Hemlock B.T. since the area to the NE of the corner had been bulldozed and cleared. We accepted the HDR Monument as a careful and faithful perpetuation of the position of the original corner.


C. Description of monument for corner and accessories established to perpetuate locating the position of the corner:
Accepted existing 3/4 inch diameter aluminum rod with 3-1/4 inch diameter aluminum cap:

7" dia. Cedar	S60°E	22.99 feet	Scr. NBT
5" dia. Cedar	S60°W	48.39 feet	Scr. NBT
7" dia. Cedar	N58°W	23.05 feet	Scr. NBT
12" dia. Cedar	N22°W	43.97 feet	Scr. NBT
Metal Survey Sign Post	N48°E	1.0 feet	

NOTE: All bearings are magnetic bearings. All distances are measured with steel tape. Distances to trees are to nail in side of tree.

Signed by William Lenca
Surveyor's Michigan License No. 26461

Date Dec. 13, 1995

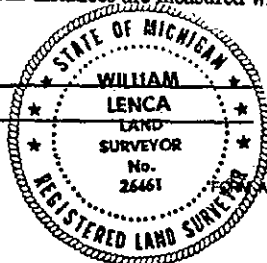

APPROVED BY MICHIGAN STATE BOARD OF PROFESSIONAL SURVEYORS, JAN. 28,
REVISED MAY 14,
REVISED JAN.,
REVISED OCT.,