

LAND CORNER RECORDATION CERTIFICATE  
 Filing Requirement of Act 74, Mich. P.A. 1970

For corners in  
MENOMINEE  
 (County)


	Located In:	Corner Code #
1. Public Land Survey	T <u>37</u> N R <u>25</u> W	<u>E-9</u>
	T _____ R _____	_____
	T _____ R _____	_____
	T _____ R _____	_____
2. Property Controlling in Section	S _____ T _____ R _____	_____
	S _____ T _____ R _____	_____
3. Miscellaneous Property in Sec.	S _____ T _____ R _____	_____
	S _____ T _____ R _____	_____

RECEIVED FOR RECORD  
 95 DEC 27 PM 3:31  
 PAGE # 300 BK 1  
 DALE BASA NOTARION  
 REGISTER OF DEEDS  
 MENOMINEE, MICHIGAN  
 Register of Deeds Stamp & File Number

4. Lot No. \_\_\_\_\_, Recorded Plat \_\_\_\_\_  
 5. Private Claims \_\_\_\_\_

I, William Lenca, in a field survey on Nov. 10, 19 95 do hereby state that under requirements of P.A. 74, Michigan P.A. of 1970, the corner points mentioned in lines 1 and 2 above were in conformance with regulations and rules therefore as required in the current manual of survey instructions of the United States Department of the Interior, Bureau of Land Management or by a decree of a Court of Law and /or that the corner points mentioned in lines 3, 4 and 5 above were in conformance with the rules of the Michigan Board of Land Surveyors or by a Decree of a Court of Law; established, re-established, monumented, recovered, found as expressed below:

NOTE: Not more than 2 corners, all in the same town and range, may be recorded on this certificate.

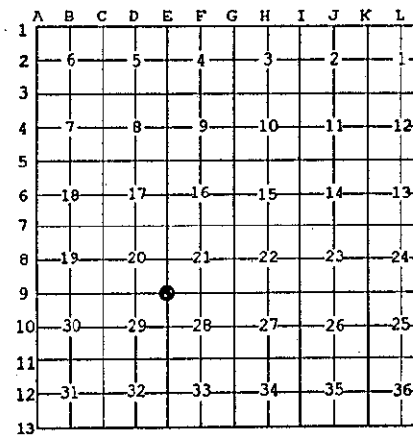

A. Description of original monument and accessories and/or subsequent restoration:

- 1852: Original Survey by George Adair - B.T.'s - Hemlock, 14" - N73°W - 20 lks; Cedar, 16" - S38°E - 34 lks. All original evidence for this corner has been destroyed by county road improvements.
- 1994: L.C.R.C. No. 81, Book 4, recorded by Edward Kazianka, RLS No. 14765, states "Set corner in centerline of road, south of last post of ancient fenceline from the west. Corner is 2634.2' west and 2625.74' east of recorded quarter corners. This point is 1.2' east of proportionate position. Set 2" No. 5 rerod" Ties: Cedar, 6" - S39W - 41.45'; Cedar, 6" - S36E - 48.90'; Cedar, 12" - N53E - 48.75'.

B. Description of corner evidence found and/or method applied in restoring or reestablishing corner:

In our 1995 Remonumentation Survey in T37N-R25W, we recovered a 5/8" x 24" iron rod in the centerline of an East - West County Road and in line with a fence corner post to the North. We also recovered all 4 Bearing Trees noted in L.C.R.C. No. 81, Book 4, in good condition. Since Kazianka's position fits well with a proportionate location East - West, and there is evidence of occupation to the North, we accepted the corner as the best available evidence of the position of the original corner.

C. Description of monument for corner and accessories established to perpetuate locating the position of the corner:  
 Set 2" dia. Aluminum Pipe/3-1/4" dia. Alum cap stamped for corner location:

12" dia. Maple	N65°E	47.22 feet	Scr. NBT
6" dia. Cedar - Existing NBT	S36°E	48.90 feet	Scr. NBT
6" dia. Cedar - Existing NBT	S39°W	41.45 feet	Scr. NBT
10" dia. Cedar	N50°W	42.88 feet	Scr. NBT
Metal Survey Sign Post	N04°E	26.0 feet	

NOTE: All bearings are magnetic bearings. All distances are measured with steel tape. Distances to trees are to nail in side of tree.

Signed by William Lenca  
 Surveyor's Michigan License No. 26461

Date Dec. 13, 1995

