

LAND CORNER RECORDATION CERTIFICATE
Filing Requirement of Act 74, Mich. P.A. 1970

For corners in
MENOMINEE
(County)

Located In: Corner Code #


1. Public Land Survey T37N R 25W G08
T R
T R
T R

2. Property Controlling
in Section S T R
S T R

3. Miscellaneous
Property in Sec. S T R
S T R

4. Lot No. _____, Recorded Plat _____

5. Private Claims _____

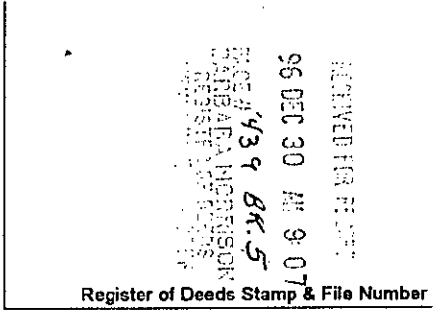

I, William Lenca, in a field survey on Jun. 19, 1996 do hereby state that under requirements of P.A. 74, Michigan P.A. of 1970, the corner points mentioned in lines 1 and 2 above were in conformance with regulations and rules therefore as required in the current manual of survey instructions of the United States Department of the Interior, Bureau of Land Management or by a decree of a Court of Law and /or that the corner points mentioned in lines 3, 4 and 5 above were in conformance with the rules of the Michigan Board of Land Surveyors or by a Decree of a Court of Law; established, re-established, monumented, recovered, found as expressed below:

NOTE: Not more than 2 corners, all in the same town and range, may be recorded on this certificate.

| | | | | | | | | | | | | |
|----|----|----|----|----|----|----|---|---|---|---|---|---|
| A | B | C | D | E | F | G | H | I | J | K | L | M |
| 1 | | | | | | | | | | | | |
| 2 | 6 | 5 | 4 | 3 | 2 | 1 | | | | | | |
| 3 | | | | | | | | | | | | |
| 4 | 7 | 8 | 9 | 10 | 11 | 12 | | | | | | |
| 5 | | | | | | | | | | | | |
| 6 | 10 | 17 | 16 | 15 | 14 | 13 | | | | | | |
| 7 | | | | | | | | | | | | |
| 8 | 19 | 20 | 21 | 22 | 23 | 24 | | | | | | |
| 9 | | | | | | | | | | | | |
| 10 | 30 | 29 | 28 | 27 | 26 | 25 | | | | | | |
| 11 | | | | | | | | | | | | |
| 12 | 31 | 32 | 33 | 34 | 35 | 36 | | | | | | |
| 13 | | | | | | | | | | | | |

A. Description of original monument and accessories and/or subsequent restoration:

- 1852: Original Survey by George Adair - B.T.'s - Cedar, 14° - N40°E - 5 lks.; Ironwood, 9° - S40°W - 28 lks. All original evidence for this corner has been destroyed by county road improvements.
- 1985: L.C.R.C. No. 693 recorded by George B. Wilson, RLS No. 17607, states: "Set at road intersection, proportional method not used here." Set W-1-B Berntsen Road Monument, magnet in base - Deep - 1 - 25.33' NW and 24.16' NE. Sketch on the back of this form shows this corner as it relates to other corners in Section 21, T37N-R25W.

B. Description of corner evidence found and/or method applied in restoring or reestablishing corner:

We recovered a broken W-1-B Berntsen Road Monument in the centerline of county roads running East - West and North - South. Although the cap was sheared off, the monument was still in an upright position, and we were able to determine the center point for the corner. The position of the existing monument fits well with corners 1/2 mile South and 1/2 mile North, has been used by local surveyors for several years, and is accepted as the best available evidence of the position of the original corner.



C. Description of monument for corner and accessories established to perpetuate locating the position of the corner:
Set 5/8" x 24" Iron Rod/3-1/4" dia. Alum. cap stamped for corner location in Monument Box:

| | | | |
|---|-------|------------|-------------------|
| 5/8" x 24" Iron Rod/2" dia. Alum. cap marked "WITNESS MARKER" | N47°E | 43.59 feet | 1' S. of Tel. Box |
| 5/8" x 24" Iron Rod/2" dia. Alum. cap marked "WITNESS MARKER" | S38°E | 39.96 feet | 1' N. of Tel. Box |
| 5/8" x 24" Iron Rod/2" dia. Alum. cap marked "WITNESS MARKER" | N45°W | 47.59 feet | |
| Metal Survey Sign Post | N45°W | 48.1 feet | |
| Nothing else nearby | | | |

NOTE: All bearings are magnetic bearings. All distances are measured with steel tape. Distances to trees are to nail in side of tree.

Signed by William Lenca
Surveyor's Michigan License No. 26461

Date Dec. 23, 1996