

# SURVEY & REMONUMENTATION

APR 24 1995

## LAND CORNER RECORDATION CERTIFICATE Filing Requirement of Act 74, Mich. P.A. 1970

Approved by Menominee County  
Land Survey Remonumentation  
Fee Group Under Act 345 Of  
P.A. of 1990 On DEC 12, 199 4  
*McL Davis BLS*

For corners in **COMMISSION**

<u>MENOMINEE</u> <small>(County)</small>	Located In:	Corner Code #	
1. Public Land Survey	T <u>37N</u> R <u>25W</u>	<u>K-2</u>	
	T _____ R _____	_____	
	T _____ R _____	_____	
	T _____ R _____	_____	
2. Property Controlling in Section	S _____ T _____ R _____	_____	
	S _____ T _____ R _____	_____	
3. Miscellaneous Property in Sec.	S _____ T _____ R _____	_____	
	S _____ T _____ R _____	_____	
4. Lot No. _____, Recorded Plat _____			
5. Private Claims _____			

RECEIVED FOR RECORD  
DEC 27 AM 10:47  
SARA MORRISON  
REGISTER OF DEEDS  
MENOMINEE, MI 49853  
ACTING CHAIRMAN  
Bk 4

**Register of Deeds Stamp & File Number**

I, William Lenca, in a field survey on Sep 29, 19 94, do hereby certify that under requirements of P.A. 74, Michigan P.A. of 1970, the corner points mentioned in lines 1 and 2 above were in conformance with regulations and rules therefore as required in the current manual of survey instructions of the United States Department of the Interior, Bureau of Land Management or by a decree of a Court of Law and/or that the corner points mentioned in lines 3, 4 and 5 above were in conformance with the rules of the Michigan Board of Land Surveyors or by a Decree of a Court of Law; established, re-established, monumented, re-monumented, recovered, found as expressed below:

	A	B	C	D	E	F	G	H	I	J	K	L	M
2	6	5	4	3	2	1							
3													
4	7	8	9	10	11	12							
5													
6	16	17	16	15	14	13							
7													
8	19	20	21	22	23	24							
9													
10	30	29	28	27	26	25							
11													
12	31	32	33	34	35	36							
13													

**NOTE: Not more than 4 corners, all in the same town and range, may be recorded on this certificate.**

**A. Description of original monument and accessories and/or subsequent restoration:**

1853: Original Survey by George Adair - B.T.'s - Tamarack, 12" - N29°E, 16 lks; Spruce, 10" - S03°W - 11 lks. No original evidence found.


**B. Description of corner evidence found and/or method applied in restoring or reestablishing corner:**

We tied in the Southwest Corner and the Northwest Corner of Section 1, T37N-R25W, and computed the proportional position for this corner based on the GLO measurement of this line. We then traversed to our computed location and found a 2-1/2" diameter Iron Pipe with a 3-1/4" diameter Brass cap stamped for the corner location. This monument was set by the Bureau of Land Management in a survey of Indian Lands, and fits very well with the proportioned position for this corner. We therefore accepted the BLM Monument as a careful and faithful reestablishment of the position of the original corner.

**C. Description of monument for corner and accessories established to perpetuate locating the position of the corner:**

Accepted existing 2-1/2" dia. Iron Pipe/3-1/4" dia. Brass cap stamped for corner location:

7" dia. Cedar	N00°E	14.54 feet	Scr. NBT
9" dia. Cedar	S28°E	23.72 feet	Scr. NBT
10" dia. Cedar - (Ex. B.T.)	S70°W	8.48 feet	Scr. NBT
18" dia. Cedar	N41°W	15.76 feet	Scr. NBT
Survey Sign Post	N90°W	1.9 feet	

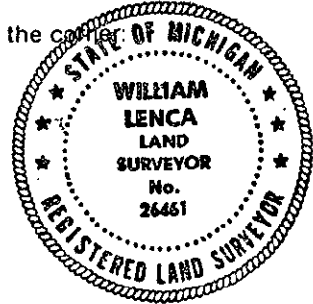

**NOTE: All bearings are magnetic bearings. All distances are measured with steel tape. Distances to trees are to nail in side of tree.**

Signed by William Lenca Date Nov. 15, 1994  
Surveyor's Michigan License No. 26461