

SURVEY & RE-MONUMENTATION

APR 06 1999

LAND CORNER RECORDATION CERTIFICATE
Filing Requirement of Act 74, Mich. P.A. 1970

Approved by Menominee County
Land Survey Remonumentation
Peer Group Under Act 345 Of

P.A. Of 1990 On 12/30, 1998

MEZ DAVIS RLS

Chairman

PAGE # 726 BKS
BARBARA MORRISON
REGISTER OF DEEDS
MENOMINEE MI 49858

99 JAN -6 AM 8:55

RECEIVED FOR RECORD

For corners in SECTION

MENOMINEE (County)	Located In:	Corner Code #
1. Public Land Survey	T <u>37N</u> R <u>27W</u>	<u>B-11</u>
	T ___ R ___	___
	T ___ R ___	___
	T ___ R ___	___
2. Property Controlling in Section	S ___ T ___ R ___	___
	S ___ T ___ R ___	___
3. Miscellaneous Property in Sec.	S ___ T ___ R ___	___
	S ___ T ___ R ___	___

Register of Deeds Stamp & File Number

4. Lot No. _____, Recorded Plat _____
5. Private Claims _____

I, William Lenca, in a field survey on Dec. 17, 1998 do hereby state that under requirements of P.A. 74, Michigan P.A. of 1970, the corner points mentioned in lines 1 and 2 above were in conformance with regulations and rules therefore as required in the current manual of survey instructions of the United States Department of the Interior, Bureau of Land Management or by a decree of a Court of Law and /or that the corner points mentioned in lines 3, 4 and 5 above were in conformance with the rules of the Michigan Board of Land Surveyors or by a Decree of a Court of Law; established, re-established, monumented, recovered, found as expressed below:

NOTE: Not more than 2 corners, all in the same town and range, may be recorded on this certificate.

	A	B	C	D	E	F	G	H	I	J	K	L	M
1													
2	6			5		4		3		2		1	
3													
4	7			8		9		10		11		12	
5													
6	10			17		16		15		14		13	
7													
8	19			20		21		22		23		24	
9													
10	30			29		28		27		26		25	
11	●												
12	31			32		33		34		35		36	
13													

A. Description of original monument and accessories and/or subsequent restoration:

- 1852: Original Survey by Francis Coleman - B.T.'s - Cedar, 8" - N34°W - 27 lks.; Tamarack, 10" - S58°E - 40 lks. All original evidence for this corner has been destroyed by logging activities.
- 1982: L.C.R.C. No. 569 by David B. Babbitt RLS No. 21558 states, "Set from stps. of both O.B.T.s Cedar 8" N24°W - 27 lks. is now a stub 4' tall with marks of overgrowth for both upper and lower faces but too badly burned for scribe marks. Tam. 10" S58°E - 40 lks. is a stump cut low and is very rotten but still shows signs of scarring and overgrowth. Also found remains of a cedar stp. 4 ft. north of this corner with a flat axe blaze facing the corner but with no other marks and not of record. Bearings and distances to both O.B.T.s are good." Set 1" pipe with 4" aluminum cap. TIES: Cedar, 4" - N54°W - 20.3'; Cedar, 5" - N40°E - 12.2'; Cedar, 6" - S50°E - 19.0'; Cedar, 7" - S51°W - 17.8'.


B. Description of corner evidence found and/or method applied in restoring or reestablishing corner:

We found a 1 inch diameter iron pipe with a 4 inch diameter aluminum cap (D.N.R. Monument) along with 3 B.T.'s (as noted in part "C") in a location as indicated in Land Corner Recordation Certificate Number 569. The original Cedar B.T. (N24°W - 27 lks) is lying on the ground. The original Tamarack B.T. (S58°E - 40 lks) is too rotted at this point to identify any marks. The corner falls on the north side of an old logging road running East, and is accepted as a careful and faithful perpetuation of the position of the original corner.

C. Description of monument for corner and accessories established to perpetuate locating the position of the corner:

Accepted existing 1" dia. Iron Pipe/4" dia. Aluminum cap (DNR monument) stamped for corner:

5" dia. Cedar	N39°E	12.38 feet	Ex. B.T.
7" dia. Cedar	S49°E	19.30 feet	Ex. B.T.
10" dia. Cedar	S13°W	16.68 feet	"X" cut in upper & lower blazes
9" dia. Cedar	S46°W	18.11 feet	Ex. B.T.
Metal Survey Sign Post	East	1.0 feet	

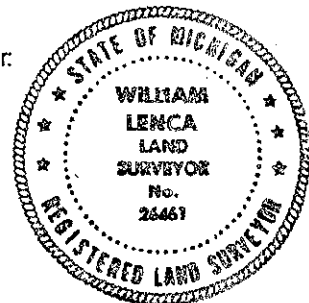

NOTE: All bearings are magnetic bearings. All distances are measured with steel tape. Distances to trees are to nail in side of tree.

Signed by William Lenca
Surveyor's Michigan License No. 26461

Date Dec. 28, 1998