

APR 06 1999

Approved by Menominee County
Land Survey Remuneration
Peer Group Under Act 345 Of
P.A. Of 1990 On 12/30 1998
Mr. Davis RLS
Chairman

SECTION

LAND CORNER RECORDATION CERTIFICATE
Filing Requirement of Act 74, Mich. P.A. 1970

For corners in

MENOMINEE

(County)

Located In:

Corner Code #

- | | | |
|------------------------------------|-----------------------------|-------|
| 1. Public Land Survey | T <u>37</u> N R <u>27</u> W | C-12 |
| | T ___ R ___ | _____ |
| | T ___ R ___ | _____ |
| | T ___ R ___ | _____ |
| 2. Property Controlling in Section | S ___ T ___ R ___ | _____ |
| | S ___ T ___ R ___ | _____ |
| 3. Miscellaneous Property in Sec. | S ___ T ___ R ___ | _____ |
| | S ___ T ___ R ___ | _____ |

RECEIVED FOR RECORD
99 JAN - 6 AM 8:56
PAGE # 228 325
BARBARA MORRISON
REGISTER OF DEEDS
MENOMINEE, MI 49850

Register of Deeds Stamp & File Number

4. Lot No. _____, Recorded Plat _____
5. Private Claims _____

William Lenca, in a field survey on Dec. 17, 1998 do hereby state that under requirements of P.A. 74, Michigan P.A. of 1970, the corner points mentioned in lines 1 and 2 above were in conformance with regulations and rules therefore as required in the current manual of survey instructions of the United States Department of the Interior, Bureau of Land Management or by a decree of a Court of Law and/or that the corner points mentioned in lines 3, 4 and 5 above were in conformance with the rules of the Michigan Board of Land Surveyors or by a Decree of a Court of Law; established, re-established, monumented, recovered, found as expressed below:

NOTE: Not more than 2 corners, all in the same town and range, may be recorded on this certificate.

	A	B	C	D	E	F	G	H	I	J	K	L	M
1													
2	6		5		4		3		2		1		
3													
4	7		8		9		10		11		12		
5													
6	18		17		16		15		14		13		
7													
8	19		20		21		22		23		24		
9													
10	30		29		28		27		26		25		
11													
12	31		32		33		34		35		36		
13													

A. Description of original monument and accessories and/or subsequent restoration:

- 1852: Original Survey by Francis Coleman - B.T.'s - W. Pine, 12" - N16°W - 49 lks.; Cedar, 14" - S75°E - 64 lks. All original evidence for this corner has been destroyed by logging activities.
1980: L.C.R.C. No. 213 by David B. Babbitt RLS No. 21558 states, "Found remains of both O.B.T. stumps both show axe marks but no scribing, they have been badly burned. Bearings and distances check very well. In addition, there is a W.P. stp. N.E. with a small blaze facing the corner position." Set 1" pipe with 4" aluminum cap. TIES: Cedar, 6" - S06°W - 41.1'; Cedar, 7" - S77°E - 43.5'; W. Spruce, 11" - N38°W - 41.15'; Twin H. Maple, 6" - N30°E - 25.8'.

B. Description of corner evidence found and/or method applied in restoring or reestablishing corner:

We found a 1 inch diameter iron pipe with a 4 inch diameter Aluminum cap (DNR Monument) and 4 bearing trees in a location as indicated in Land Corner Recordation Certificate Number 213. Remains of the two original bearing tree stumps are still visible. We accepted the existing monument as a careful and faithful perpetuation of the position of the original corner.

C. Description of monument for corner and accessories established to perpetuate locating the position of the corner:


Accepted existing 1" dia. Iron Pipe/4" dia. Alum. cap (DNR monument) stamped for corner:

6" dia. Hard Maple	N30°E	26.01 feet	Ex. B.T.
8" dia. Cedar	S77°E	43.29 feet	Ex. B.T.
9" dia. Cedar	S06°W	41.93 feet	Ex. B.T.
13" dia. White Spruce	N38°W	40.48 feet	Ex. B.T.
Metal Survey Sign Post	West	1.0 feet	

NOTE: All bearings are magnetic bearings. All distances are measured with steel tape. Distances to trees are to nail in side of tree.

Signed by William Lenca
Surveyor's Michigan License No. 26461

Date Dec. 28, 1998

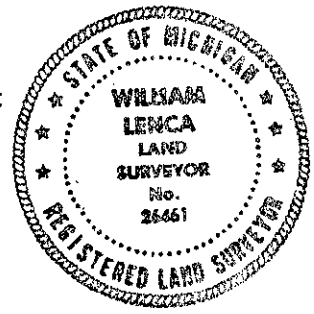

728