

LAND CORNER RECORDATION CERTIFICATE
Filing Requirement of Act 74, Mich. P.A. 1970

Approved by Menominee County
Land Survey Remonumentation
Peer Group Under Act 345 Of

P.A. Of 1990 On 12/12 1996

For corners in

MENOMINEE
(County)

Located in: Corner Code #

- | | | |
|------------------------------------|---------------------------|------------|
| 1. Public Land Survey | T <u>37N</u> R <u>27W</u> | <u>G-7</u> |
| | T _____ R _____ | _____ |
| | T _____ R _____ | _____ |
| | T _____ R _____ | _____ |
| 2. Property Controlling in Section | S _____ T _____ R _____ | _____ |
| | S _____ T _____ R _____ | _____ |
| 3. Miscellaneous Property in Sec. | S _____ T _____ R _____ | _____ |
| | S _____ T _____ R _____ | _____ |


Chairman
DEC 20 AM 9:33
RECEIVED FOR RECORD
BARBARA MORTONSON
REGISTER OF DEEDS
COUNTY OF MENOMINEE

Register of Deeds Stamp & File Number

4. Lot No. _____, Recorded Plat _____
5. Private Claims _____

I, William Lenca, in a field survey on Oct. 14, 1996 do hereby state that under requirements of P.A. 74, Michigan P.A. of 1970, the corner points mentioned in lines 1 and 2 above were in conformance with regulations and rules therefore as required in the current manual of survey instructions of the United States Department of the Interior, Bureau of Land Management or by a decree of a Court of Law and /or that the corner points mentioned in lines 3, 4 and 5 above were in conformance with the rules of the Michigan Board of Land Surveyors or by a decree of a Court of Law; established, re-established, monumented, recovered, found as expressed below:

NOTE: Not more than 2 corners, all in the same town and range, may be recorded on this certificate.

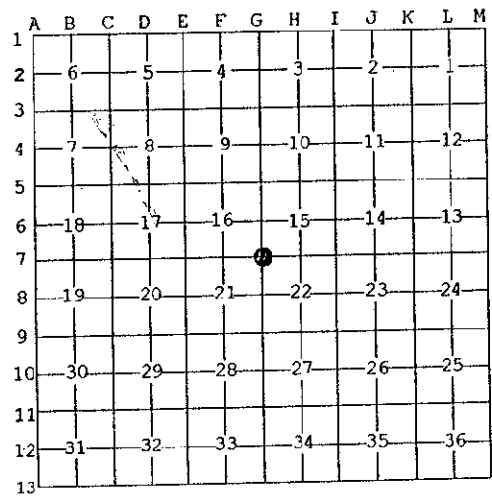

A. Description of original monument and accessories and/or subsequent restoration:

- 1852: Original Survey by Francis Colcman - B.T.'s - White Pine, 10" - N54°W - 27 lks; Cedar, 18" - S13°E - 09 lks.
- 1985: L.C.R.C. No. 703 by David Babbitt, RLS No. 21558, states that "Found iron rod with stump remains in place for both OBT's. Too rotted to show any marks of orig. survey, but species and size are correct, swamp calls 3 chs. E and 2.14 chs. S are reasonable. Mea. to known corners N-S & W compare favorably with other measurements in this twp." - Set DNR mon. - B.T.'s - 12" Ced. - S85°E - 62.7'; 5" w. spruce - S20°E - 30.3'; 5" w. spruce - S56°W - 73.0'; 5" balsam fir - N8°E - 18.3'.

B. Description of corner evidence found and/or method applied in restoring or reestablishing corner:

We found a 1" diameter Iron Pipe/4" Aluminum cap set next to old 5/8 inch diameter iron and 4 B.T.'s as described in L.C.R.C. No. 703 noted in part "A" above. Rotted remains of original B.T.'s are still visible, but in very poor condition. We accepted the existing DNR Monument as a careful and faithful perpetuation of the position of the original corner. (NOTE: differences in distances to B.T.'s from those recorded in L.C.R.C. No. 703 are due to the fact that our measurements were taken from nails in the side of the tree while DNR measurements were taken to the face of the tree.)

C. Description of monument for corner and accessories established to perpetuate locating the position of the corner:

Accepted existing 1" dia. Iron Pipe/4" dia. Alum. cap stamped for corner location (DNR Monument):

8" dia. Balsam Fir (Ex. B.T.)	N08°E	18.53 feet	Scr. NBT
8" dia. Elm	S20°E	5.49 feet	Scr. NBT
14" dia. Cedar (Ex. B.T.)	S85°E	63.24 feet	Scr. NBT
9" dia. White Spruce (Ex. B.T.)	S56°W	73.14 feet	Scr. NBT
Metal Survey Sign Post	South	1.25 feet	

NOTE: All bearings are magnetic bearings. All distances are measured with steel tape. Distances to trees are to nail in side of tree.

Signed by William Lenca
Surveyor's Michigan License No. 26461

Date Oct. 31, 1996