

LAND CORNER RECORDATION CERTIFICATE
 Filing Requirement of Act 74, Mich. P.A. 1970

Approved by Menominee County
 Land Survey Reorganization
 Peer Group Under Act 345 Of
 P.A. Of 1990 On 12/16 1990

For corners in
MENOMINEE
 (County)

Located In: Corner Code #

1. Public Land Survey T 37N R 27W _____ H-5
 T _____ R _____
 T _____ R _____
 T _____ R _____


2. Property Controlling S _____ T _____ R _____
 in Section S _____ T _____ R _____

3. Miscellaneous S _____ T _____ R _____
 Property in Sec. S _____ T _____ R _____

4. Lot No. _____, Recorded Plat _____

5. Private Claims _____

Chairman
McDonis Res
 5 DEC 20 AM 9:33
 REGISTER OF DEEDS
 MENOMINEE COUNTY
 REGISTER OF DEEDS STAMP & FILE NUMBER

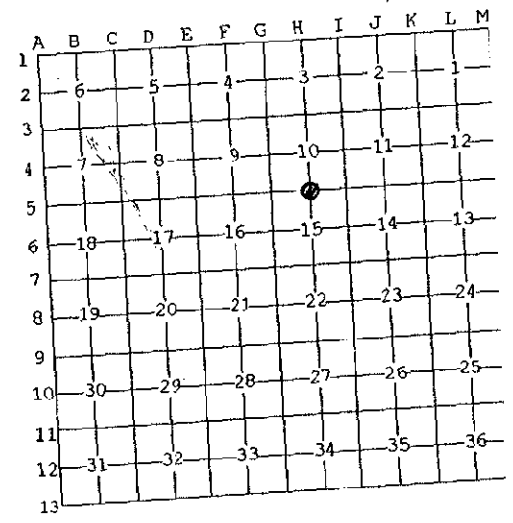

I, William Lenca, in a field survey on Oct. 24, 1996, do hereby state that under requirements of P.A. 74, Michigan P.A. of 1970, the corner points mentioned in lines 1 and 2 above were in conformance with regulations and rules therefore as required in the current manual of survey instructions of the United States Department of the Interior, Bureau of Land Management or by a decree of a Court of Law and/or that the corner points mentioned in lines 3, 4 and 5 above were in conformance with the rules of the Michigan Board of Land Surveyors or by a Decree of a Court of Law; established, re-established, monumented, recovered, found as expressed below:

NOTE: Not more than 2 corners, all in the same town and range, may be recorded on this certificate.

A. Description of original monument and accessories and/or subsequent restoration:
 1852: Original Survey by Francis Coleman - B.T.'s - Hemlock, 10" - N40°W - 08 lks; Sugar, 14" - S28°E - 31 lks. All original evidence for this corner has been destroyed by county road improvements.

B. Description of corner evidence found and/or method applied in restoring or reestablishing corner:
 We set this corner in line with county road centerlines running East - West and midway between the Northwest Corner and the Northeast Corner of Section 15. We accepted this location as the best available evidence of the position of the original corner

C. Description of monument for corner and accessories established to perpetuate locating the position of the corner:
 Set 5/8" x 24" Iron Rod/3-1/4" dia. Alum. cap stamped for corner location 6" below gravel road surface:

- | | | | |
|---|-------|------------|------------|
| 5/8" x 24" Iron Rod/Ident. cap "MI 26461/WI 1569" | S63°W | 76.57 feet | |
| 12" dia. White Pine | N54°E | 48.72 feet | Scr. NBT |
| 11" dia. White Pine | S34°E | 32.30 feet | Not blazed |
| 10" dia. White Pine | N35°W | 34.23 feet | Scr. NBT |
| Metal Survey Sign Post | North | 34.2 feet | |

NOTE: All bearings are magnetic bearings. All distances are measured with steel tape. Distances to trees are to nail in side of tree.

Signed by William Lenca
 Surveyor's Michigan License No. 26461

Date Oct. 31, 1996