

MAR 29 2000

SECTION

LAND CORNER RECORDATION CERTIFICATE
Filing Requirement of Act 74, Mich. P.A. 1970

Approved by Menominee County
Land Survey Remonumentation
Peer Group Under Act 345 Of
P.A. of 1990 On 12/23, 1999
Mike Davis RLS
Chairman

BK 6 Pg. 47

RECEIVED FOR RECORD
28 DEC 1999 3:56:09 PM
BARBARA MORRISON
REGISTER OF DEEDS
MENOMINEE, MI 49858

For corners in
MENOMINEE
(County)

Located In:	Corner Code #
T 37N R 26W	A-11
T R	
T R	
T R	
T R	
S T R	
S T R	
S T R	
S T R	

- 1. Public Land Survey
- 2. Property Controlling in Section
- 3. Miscellaneous Property in Sec.

Register of Deeds Stamp & File Number

4. Lot No. , Recorded Plat
5. Private Claims
SAME AS CORNER M-11 T37N-R27W

I, William Lenca, in a field survey on May, 1999 do hereby state that under requirements of P.A. 74, Michigan P.A. of 1970, the corner points mentioned in lines 1 and 2 above were in conformance with regulations and rules therefore as required in the current manual of survey instructions of the United States Department of the Interior, Bureau of Land Management or by a decree of a Court of Law and/or that the corner points mentioned in lines 3, 4 and 5 above were in conformance with the rules of the Michigan Board of Land Surveyors or by a Decree of a Court of Law; established, re-established, monumented, recovered, found as expressed below:

NOTE: Not more than 2 corners, all in the same town and range, may be recorded on this certificate.

A. Description of original monument and accessories and/or subsequent restoration:

- 1848: Original Survey by James H. Mullett - B.T.'s - Cedar, 12" - N58°E - 40 lks.; Y. Birch, 10" - S72°E - 29 lks. All original evidence for this corner has been destroyed by farming activities.
- 1852: Original Survey by Francis Coleman - B.T.'s - Birch, 18" - S18°W - 26 lks.; Birch, 18" - N28°W - 27 lks. All original evidence for this corner has been destroyed by farming activities.
- 1963: L.C.R.C. No. 809 (Vol. 3) by C.C. Lindgren, M.S.H.D., states Fd 4" sq. Cedar Post with use of old notes - B.T.'s: 8" Cedar - S60°E - 27.34'; 6" Elm - N30°W - 9.85'; 6" Poplar - N25°E - 29.39'.
- 1988: Certified Survey No. 597 by William Lenca, RLS No. 26461, shows this corner as it relates to other corners in Section 30.


B. Description of corner evidence found and/or method applied in restoring or reestablishing corner:

We found a 5/8 inch x 24 inch iron rod which was set in our 1988 survey and subdivision of Section 30, T37N-R26W, from C.C. Lindgren's B.T.'s as described in L.C.R.C. No. 809 (Vol. 3). The corner falls at an ancient fence corner. This position fits well with other corners in Section 30, has been used for many years by local surveyor's, and is accepted as the best available evidence of the position of the original corner.

C. Description of monument for corner and accessories established to perpetuate locating the position of the corner:

Set 3/4" dia. x 4' long aluminum rod/3-1/4" dia. Alum. cap stamped for corner.

9" dia. Cedar	N80°E	33.53 feet	Scr. NBT
12" dia. White Spruce	S06°W	30.47 feet	Scr. NBT
7" dia. Cedar	N85°W	32.28 feet	Scr. NBT
10" White Ash	S33°E	18.31 feet	Scr. NBT
Metal Survey Sign Post	North	1.0 feet	

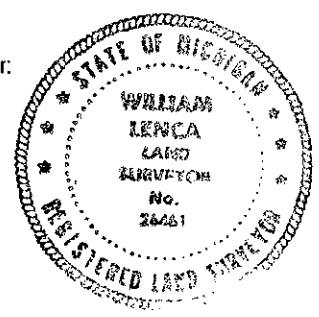

NOTE: All bearings are magnetic bearings. All distances are measured with steel tape. Distances to trees are to nail in side of tree.

Signed by William Lenca
Surveyor's Michigan License No. 26461

Date July 9, 1999