

APR 06 1999

Approved by Menominee County
Land Survey Remonumentation
Peer Group Under Act 345 Of

P.A. Of 1990 On 12/30, 1998

Ma Dawn RLS
Chairman

SECTION

LAND CORNER RECORDATION CERTIFICATE
Filing Requirement of Act 74, Mich. P.A. 1970

Chairman
99 JAN - 6 AM 8:55
PAGE # 724 BRS
BARBARA MORRISON
REGISTER OF DEEDS
MENOMINEE MI 49958

RECEIVED FOR RECORD

For corners in

MENOMINEE
(County)

Located In:

Corner Code #

- 1. Public Land Survey T37N R 27W A-12
T R
T R
T R
- 2. Property Controlling in Section S T R
S T R
- 3. Miscellaneous Property in Sec. S T R
S T R

Register of Deeds Stamp & File Number

- 4. Lot No. _____, Recorded Plat _____
- 5. Private Claims _____

(SAME AS CORNER M-12, T37N - R28W)

I, William Lenca, in a field survey on Dec. 17, 1998 do hereby state that under requirements of P.A. 74, Michigan P.A. of 1970, the corner points mentioned in lines 1 and 2 above were in conformance with regulations and rules therefore as required in the current manual of survey instructions of the United States Department of the Interior, Bureau of Land Management or by a decree of a Court of Law and/or that the corner points mentioned in lines 3, 4 and 5 above were in conformance with the rules of the Michigan Board of Land Surveyors or by a Decree of a Court of Law; established, re-established, monumented, recovered, found as expressed below:

NOTE: Not more than 2 corners, all in the same town and range, may be recorded on this certificate.

	A	B	C	D	E	F	G	H	I	J	K	L	M
1													
2		6		5		4		3		2		1	
3													
4		7		8		9		10		11		12	
5													
6		18		17		16		15		14		13	
7													
8		19		20		21		22		23		24	
9													
10		30		29		28		27		26		25	
11													
12		31		32		33		34		35		36	
13													

A. Description of original monument and accessories and/or subsequent restoration:

- 1848: Original Survey by H. Brevoort, Jr. - B.T.'s - Cedar, 10" - S80°W - 04 lks.; Tamarack, 10" - N55°E - 22 lks. All original evidence for this corner has been destroyed by logging activities.
- 1976: L.C.R.C. No. 133 by David B. Babbitt RLS No. 21558 states, "Set from stump of cedar O.B.T. recorded as cedar 10 - S80°W - 04 - tam. roots in place for N.E. O.B.T. Cedar stump shows burned out upper & lower face and a "T" in the overgrowth on upper face. The E-W position of this corner is also verified by a very old tam. stub about 300' south with a definite blaze on both north and south sides and about 2" of overgrowth on the blazes. Believed marked as a sight tree on the original gov't survey." Set 1" pipe with 4" aluminum cap. TIES: Cedar, 7" - N84°E - 13.8'; Cedar, 7" - N66°W - 9.1'; Cedar, 8" - N11°W - 21.2'.


B. Description of corner evidence found and/or method applied in restoring or reestablishing corner:

We found a D.N.R. Monument and 3 bearing trees in a location as indicated in Land Corner Recordation Certificate Number 133 by David B. Babbitt, RLS No. 21558. Remains stump of Original Cedar B.T. (Cedar 10" - S80°W - 04 lks) are still visible. We accepted this corner position as a careful and faithful perpetuation of the position of the original corner.

C. Description of monument for corner and accessories established to perpetuate locating the position of the corner:

Accepted existing DNR monument for corner:

- 9" dia. Cedar N82°E 14.14 feet Ex. B.T.
- 5" dia. Cedar S25°E 21.59 feet "X" cut in upper & lower blazes
- 9" dia. Cedar N73°W 9.25 feet Ex. B.T.
- 11" dia. Cedar N12°W 21.53 feet Ex. B.T.
- Metal Survey Sign Post North 1.0 feet

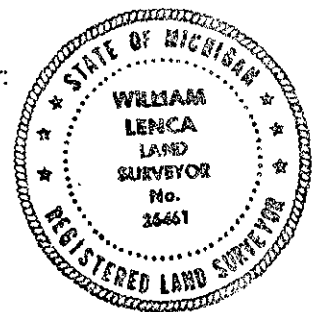

NOTE: All bearings are magnetic bearings. All distances are measured with steel tape. Distances to trees are to nail in side of tree.

Signed by William Lenca
Surveyor's Michigan License No. 26461

Date Dec. 28, 1998