

SURVEY & REMONUMENTATION

MAR 29 2000

SECTION

LAND CORNER RECORDATION CERTIFICATE
Filing Requirement of Act 74, Mich. P.A. 1970

Approved by Menominee County
Land Survey Remonumentation
Peer Group Under Act 345 Of

P.A. Of 1990 On 12/28 1999

Met Danni RLS
Chairman

BK 6 Pg. 50

RECEIVED FOR RECORD
28 DEC 1999 3:56:09 PM
BARBARA MORRISON
REGISTER OF DEEDS
MENOMINEE, MI 49858

Register of Deeds Stamp & File Number

For corners in
MENOMINEE
(County)

Located In: Corner Code #

1. Public Land Survey	T <u>37N</u> R <u>26W</u>	<u>C09</u>
	T ___ R ___	_____
	T ___ R ___	_____
	T ___ R ___	_____
2. Property Controlling in Section	S ___ T ___ R ___	_____
	S ___ T ___ R ___	_____
3. Miscellaneous Property in Sec.	S ___ T ___ R ___	_____
	S ___ T ___ R ___	_____

4. Lot No. _____, Recorded Plat _____

5. Private Claims _____

	A	B	C	D	E	F	G	H	I	J	K	L	M
1													
2	6		5		4		3		2		1		
3													
4	7		8		9		10		11		12		
5													
6	10		17		16		15		14		13		
7													
8	19		20		21		22		23		24		
9													
10	30		29		28		27		26		25		
11													
12	31		32		33		34		35		36		
13													

I, William Lenca, in a field survey on June, 1999 do hereby state that under requirements of P.A. 74, Michigan P.A. of 1970, the corner points mentioned in lines 1 and 2 above were in conformance with regulations and rules therefore as required in the current manual of survey instructions of the United States Department of the Interior, Bureau of Land Management or by a decree of a Court of Law and/or that the corner points mentioned in lines 3, 4 and 5 above were in conformance with the rules of the Michigan Board of Land Surveyors or by a Decree of a Court of Law; established, re-established, monumented, recovered, found as expressed below:

NOTE: Not more than 2 corners, all in the same town and range, may be recorded on this certificate.

A. Description of original monument and accessories and/or subsequent restoration:

- 1852: Original Survey by Francis Coleman - B.T.'s - Cedar, 14" - N15°W - 7 lks.; Elm, 8" - S63°E - 22 lks. All original evidence for this corner has been destroyed by farming activities.
- 1963: L.C.R.C. No. 807 (Vol. 3) by C.C. Lindgren, M.S.H.D. - Fd. 1" Axle shaft by use of old notes - B.T.'s: Fe. Post - S50°E - 44.06'; Fe. Post - N30°E - 42.75'; 14" Box Elder - N60°W - 38.68'.


B. Description of corner evidence found and/or method applied in restoring or reestablishing corner:

We recovered a 1 inch diameter axle shaft in line with the centerline of a county road running north and with an ancient occupation line running West. The Ties mentioned in L.C.R.C. No. 807 (Vol. 3) have been destroyed. The position of the axle shaft fits well with measurements to other corners in the area, has been consistently used by local surveyors for over 35 years, and is accepted as the best available evidence of the position of the original corner.

C. Description of monument for corner and accessories established to perpetuate locating the position of the corner:

Set 2" dia. Aluminum Pipe 30" long/3-1/4" dia. Alum cap stamped for corner location:

- | | | | |
|---------------------------------------------------------------|-------|------------|------------------------|
| 5/8" x 24" Iron Rod/2" dia. Alum. cap marked "WITNESS MARKER" | N37°W | 39.64 feet | 1' SE of Power Pole |
| 5/8" x 24" Iron Rod/2" dia. Alum. cap marked "WITNESS MARKER" | N65°E | 54.94 feet | 1.5' SW of 8" Fc. Post |
| 14" dia. Elm | N85°W | 41.62 feet | Scr. NBT |
| Metal Survey Sign Post | South | 1.15 feet | |

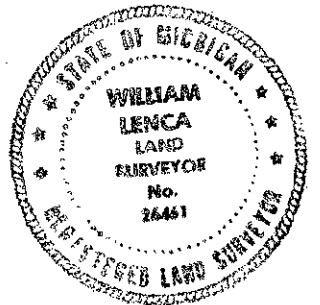

NOTE: All bearings are magnetic bearings. All distances are measured with steel tape. Distances to trees are to nail in side of tree.

Signed by William Lenca 26461
Surveyor's Michigan License No. _____

Date Dec. 21, 1999