

**SURVEY &
REMONUMENTATION**

MAR 29 2000

SECTION

**LAND CORNER RECORDATION CERTIFICATE
Filing Requirement of Act 74, Mich. P.A. 1970**

For corners in
MENOMINEE

(County)

Located In:

Corner Code #

- | | | | | |
|---------------------------------------|---------------------------------|----------|--------------------|-------------|
| 1. Public Land Survey | <u>T</u> ³⁷ <u>N</u> | <u>R</u> | <u>26</u> <u>W</u> | <u>C-11</u> |
| | <u>T</u> | <u>R</u> | | |
| | <u>T</u> | <u>R</u> | | |
| | <u>T</u> | <u>R</u> | | |
| 2. Property Controlling
in Section | <u>S</u> | <u>T</u> | <u>R</u> | |
| | <u>S</u> | <u>T</u> | <u>R</u> | |
| 3. Miscellaneous
Property in Sec. | <u>S</u> | <u>T</u> | <u>R</u> | |
| | <u>S</u> | <u>T</u> | <u>R</u> | |

Approved by Menominee
Land Survey Remonumentation
Peer Group Under Act 74, Mich. P.A. 1970
P.A. of 1990 On _____
McGraw RLS

BK 6 Pg 119

RECEIVED FOR RECORD
29 DEC 1999 12:39:41 PM
BARBARA MORRISON
REGISTER OF DEEDS
MENOMINEE, MI 49858

Register of Deeds Stamp & File Number

4. Lot No. _____, Recorded Plat _____
5. Private Claims _____

I, William Lenca, in a field survey on June, 19⁹⁹ do hereby state that under requirements of P.A. 74, Michigan P.A. of 1970, the corner points mentioned in lines 1 and 2 above were in conformance with regulations and rules therefore as required in the current manual of survey instructions of the United States Department of the Interior, Bureau of Land Management or by a decree of a Court of Law and /or that the corner points mentioned in lines 3, 4 and 5 above were in conformance with the rules of the Michigan Board of Land Surveyors or by a Decree of a Court of Law; established, re-established, monumented, recovered, found as expressed below:

NOTE: Not more than 2 corners, all in the same town and range, may be recorded on this certificate.

	A	B	C	D	E	F	G	H	I	J	K	L	M
1													
2		6		5		4		3		2		1	
3													
4		7		8		9		10		11		12	
5													
6		10		17		16		15		14		13	
7													
8		19		20		21		22		23		24	
9													
10		30		29		28		27		26		25	
11													
12		31		32		33		34		35		36	
13													

A. Description of original monument and accessories and/or subsequent restoration:

- 1852: Original Survey by Francis Coleman - B.T.'s - Sugar, 12" - N40°W - 35 lks.; Lynn, 12" - S55°E - 44 lks. All original evidence for this corner has been destroyed by County Road improvements.
1963: L.C.R.C. No. 808 (Vol. 3) by C.C. Lindgren, M.S.H.D. - Fd. Fence Corner with use of old notes. TIES: 15" Maple - N15°E - 64.80'; 6" Maple - S35°E - 54.65'; 5" Maple - S40°W - 37.15'.


B. Description of corner evidence found and/or method applied in restoring or reestablishing corner:

The fence corner position described in LCRC No. 808 (Vol. 3) has been destroyed by county road improvements. We re-established the corner position using 2 Maple B.T.'s - N15°E, 64.80 feet and S40°W, 37.15 feet described in the above mentioned LCRC. This position falls in line with ancient fences running East and South and on the North edge of a Gravel surface county road. The record distance to the Section Corner 1 mile North is 5194.02 feet compared to our measured distance of 5192.66 feet. The record distance to the Section Corner 1 mile West is 5299.70 feet compared to our measured distance of 5296.72 feet. The corner position is accepted as the best available evidence of the position of the original corner.

C. Description of monument for corner and accessories established to perpetuate locating the position of the corner:

Set 5/8" x 24" Iron Rod/3-1/4" dia. Alum. cap stamped for corner location:

- | | | | |
|---|-------|------------|-------------------------|
| 5/8" x 24" Iron Rod/2" dia. Alum. cap marked "WITNESS MARKER" | N83°E | 51.73 feet | E. side of 3" Iron Post |
| 24" dia. Maple (Ex. B.T.) | N15°E | 64.40 feet | Scr. NBT |
| 12" dia. Maple | S26°W | 46.22 feet | Scr. NBT |
| 4" dia. Ironwood | S88°W | 49.44 feet | Scr. NBT |
| Metal Survey Sign Post | N85°E | 50.0 feet | |

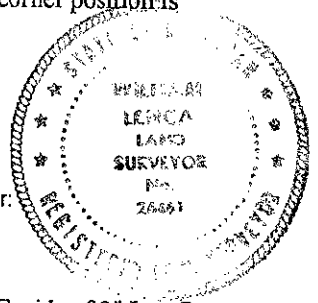

NOTE: All bearings are magnetic bearings. All distances are measured with steel tape. Distances to trees are to nail in side of tree.

Signed by William Lenca
Surveyor's Michigan License No. 26461

Date Dec. 27, 1999