

LAND CORNER RECORDATION CERTIFICATE
Filing Requirement of Act 74, Mich. P.A. 1970

P.A. Of 1990 On 12/20 1995
Mc Lewis RLS
Chairman

For corners in
MENOMINEE
(County)


Located In: Corner Code 44

		37N	26W	D-3
1. Public Land Survey	T	_____	R	_____
	T	_____	R	_____
	T	_____	R	_____
	T	_____	R	_____
2. Property Controlling in Section	S	_____	T	_____
	S	_____	T	_____
3. Miscellaneous Property in Sec.	S	_____	T	_____
	S	_____	T	_____

RECEIVED FOR RECORD
95 DEC 27 PM 3:34
PAGE # 345 BK 4
BARBARA HORTONSON
REGISTER OF DEEDS
MENOMINEE, MICHIGAN
Register of Deeds Stamp & File Number

4. Lot No. _____, Recorded Plat _____
5. Private Claims _____

William Lenca, in a field survey on Nov. 14, 1995, do hereby certify that under requirements of P.A. 74, Michigan P.A. of 1970, the corner points mentioned in lines 1 and 2 above were in conformance with regulations and rules therefore as required in the current manual of survey instructions of the United States Department of the Interior, Bureau of Land Management or by a decree of a Court of Law and/or that the corner points mentioned in lines 3, 4 and 5 above were in conformance with the rules of the Michigan Board of Land Surveyors or by a Decree of a Court of Law; established, re-established, monumented, re-monumented, recovered, found as expressed below:

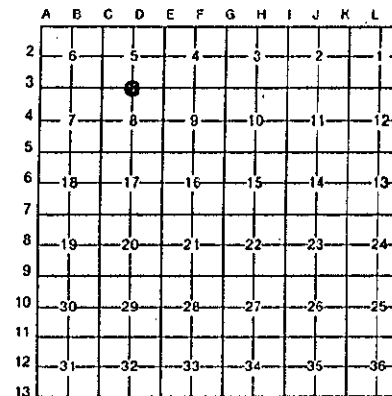

NOTE: Not more than 4 corners, all in the same town and range, may be recorded on this certificate.

A. Description of original monument and accessories and/or subsequent restoration:

- 1852: Original Survey by Francis Coleman - B.T.'s - Beech, 8" - N43°W - 78 lks; Beech, 6" - S60°E - 23 lks. All original evidence has been destroyed by county road improvements - 15 foot cut section.
1963: L.C.R.C. No. 789 (Volume 3) recorded by Clifford C. Lindgren, Party Chief for Michigan State Highway Department, states that he set a 1" dia. iron pipe from fence lines. TIES: 4" Poplar - S40°E - 32.77' (gone); 4" Cedar - S80°W - 98.00' (gone).

B. Description of corner evidence found and/or method applied in restoring or reestablishing corner:

In a 1995 Survey in Section 5, T37N-R26W, we found a 1" diameter iron pipe in the centerline of an East - West County Road at a distance of 476.7 feet West of U.S. Highway 41 centerline. Highway plans show this distance to be 477.22 feet. The distance from this corner East to the SE Corner of Section 5 is recorded in L.C.R.C. No. 789 (Volume 3) as 2647.49 feet and measured as 2646.77 feet. This corner has been used by local surveyors for 32 years, and is accepted as the best available evidence of the position of the original corner.

C. Description of monument for corner and accessories established to perpetuate locating the position of the corner:

Set 5/8" x 24" Iron Rod/3-1/4" dia. Alum. cap stamped for corner location in place of 1" dia. Iron Pipe:

6" dia. Cedar	S70°E	59.06 feet	Scr. NBT
8" dia. Cedar	S29°W	24.38 feet	Scr. NBT
10" dia. Cedar	S72°W	63.89 feet	Scr NBT
Metal Survey Sign Post	North	29.3 feet	

NOTE: All bearings are magnetic bearings. All distances are measured with a steel tape. Distances to trees are to nearest trunk of tree.



Signed by William Lenca Date Nov. 17, 1995
Surveyor's Michigan License No. 26461