

MAR 29 2000

SECTION

LAND CORNER RECORDATION CERTIFICATE
Filing Requirement of Act 74, Mich. P.A. 1970

Approved by Menominee County
Land Survey Remonumentation
Peer Group Under Act 345 Of
P.A. Of 1990 On 12/28 1999
Mc Davis RLS
Cushman

BA. 6 Pg. 51

RECEIVED FOR RECORD
28 DEC 1999 3:56:09 PM
BARBARA MORRISON
REGISTER OF DEEDS
MENOMINEE, MI 49858


Register of Deeds Stamp & File Number

For corners in
MENOMINEE
(County)

Located In: Corner Code #

| | | |
|---------------------------------------|-----------------------------|-------------|
| 1. Public Land Survey | T <u>37</u> N R <u>26</u> W | <u>C-11</u> |
| | T ___ R ___ | _____ |
| | T ___ R ___ | _____ |
| | T ___ R ___ | _____ |
| 2. Property Controlling in Section | S ___ T ___ R ___ | _____ |
| | S ___ T ___ R ___ | _____ |
| 3. Miscellaneous Property in Sec. | S ___ T ___ R ___ | _____ |
| | S ___ T ___ R ___ | _____ |

4. Lot No. _____, Recorded Plat _____
5. Private Claims _____

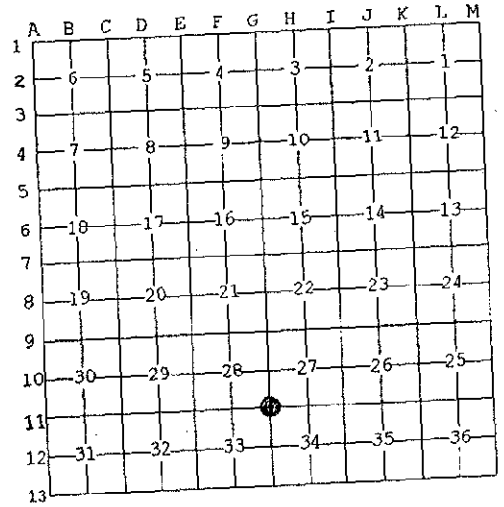

I, William Lenca, in a field survey on Dec., 1999 do hereby state that under requirements of P.A. 74, Michigan P.A. of 1970, the corner points mentioned in lines 1 and 2 above were in conformance with regulations and rules therefore as required in the current manual of survey instructions of the United States Department of the Interior, Bureau of Land Management or by a decree of a Court of Law and/or that the corner points mentioned in lines 3, 4 and 5 above were in conformance with the rules of the Michigan Board of Land Surveyors or by a Decree of a Court of Law; established, re-established, monumented, recovered, found as expressed below:

NOTE: Not more than 2 corners, all in the same town and range, may be recorded on this certificate.

A. Description of original monument and accessories and/or subsequent restoration:

- 1852: Original Survey by Francis Coleman - B.T.'s - Beech, 12" - N48°E - 11 lks.; Sugar, 12" - S32°W - 33 lks. All original evidence for this corner has been destroyed by county road improvements.
- 1989: L.C.R.C. No. 843 by William Lenca, RLS No. 26461, states "set 1/2" x 24" Iron/Ident. cap in line with ancient fence West, c/1 of old lane East and c/1 of Co. Rd. N-S. TIES: Power Pole - N49°E - 53.66'; Cedar, 4" - S40°E - 35.71'; Power Pole - S34°W - 49.85'; Cedar, 8" - S88°W - 32.96'.

B. Description of corner evidence found and/or method applied in restoring or reestablishing corner:

We recovered a 1/2 inch x 24 inch iron in position as described in L.C.R.C. No. 843 (see part A). This location fits well with measurements to corners 1/2 mile North (GLO = 2605.7' - MEAS. = 2589.72') and 1/2 mile South (GLO = 2605.7' - MEAS. = 2590.13'), and with long standing lines of occupation, and is accepted as the best available evidence of the position of the original corner.

C. Description of monument for corner and accessories established to perpetuate locating the position of the corner:

Set 5/8" x 24" Iron Rod/3-1/4" dia. Alum. cap stamped for corner location:

| | | | |
|------------------------|-------|------------|----------|
| Nail in Power Pole | N49°E | 53.66 feet | Scr. NBT |
| 4" dia. Cedar | S40°E | 35.71 feet | |
| Nail in Power Pole | S34°W | 49.85 feet | |
| 8" dia. Cedar | S88°W | 32.96 feet | Scr. NBT |
| Metal Survey Sign Post | West | 27.1 feet | |

NOTE: All bearings are magnetic bearings. All distances are measured with steel tape. Distances to trees are to nail in side of tree.

Signed by William Lenca 26461
Surveyor's Michigan License No. _____

Date Dec. 22, 1999

