

**SURVEY &  
REMONUMENTATION**

**MAR 29 2000**

**SECTION**

**LAND CORNER RECORDATION CERTIFICATE  
Filing Requirement of Act 74, Mich. P.A. 1970**

Approved by Menominee County  
Land Survey Remonumentation  
Peer Group Under Act 345 Of  
P.A. Of 1990 On 12/22, 1999  
Mc Davis RLS  
Chairman

BK. 6 Pg. 52

RECEIVED FOR RECORD  
28 DEC 1999 3:56:08 PM  
BARBARA MORRISON  
REGISTER OF DEEDS  
MENOMINEE, MI 49858

Register of Deeds Stamp & File Number

For corners in <u>MENOMINEE</u> (County)	Located In:	Corner Code #
1. Public Land Survey	T <u>37N</u> R <u>26W</u>	<u>G-12</u>
	T ___ R ___	_____
	T ___ R ___	_____
	T ___ R ___	_____
2. Property Controlling in Section	S ___ T ___ R ___	_____
	S ___ T ___ R ___	_____
3. Miscellaneous Property in Sec.	S ___ T ___ R ___	_____
	S ___ T ___ R ___	_____

4. Lot No. \_\_\_\_\_, Recorded Plat \_\_\_\_\_  
5. Private Claims \_\_\_\_\_

I, William Lenca, in a field survey on Dec., 1999 do hereby state that under requirements of P.A. 74, Michigan P.A. of 1970, the corner points mentioned in lines 1 and 2 above were in conformance with regulations and rules therefore as required in the current manual of survey instructions of the United States Department of the Interior, Bureau of Land Management or by a decree of a Court of Law and/or that the corner points mentioned in lines 3, 4 and 5 above were in conformance with the rules of the Michigan Board of Land Surveyors or by a Decree of a Court of Law; established, re-established, monumented, recovered, found as expressed below:

NOTE: Not more than 2 corners, all in the same town and range, may be recorded on this certificate.

	A	B	C	D	E	F	G	H	I	J	K	L	M
1													
2		5		5		4		3		2		1	
3													
4		7		8		9		10		11		12	
5													
6		19		17		16		15		14		13	
7													
8		19		20		21		22		23		24	
9													
10		30		29		28		27		26		25	
11													
12		31		32		33		34		35		36	
13													

**A. Description of original monument and accessories and/or subsequent restoration:**

- 1852: Original Survey by Francis Coleman - B.T.'s - Tamarack, 10" - N80°E - 46 lks.; Tamarack, 10" - S75°W - 06 lks. All original evidence for this corner has been destroyed by county road improvements.
- 1989: L.C.R.C. No. 842 by William Lenca, RLS No. 26461, states "set 5/8" x 24" Iron/Ident. cap in line with Co. Rd. c/I North and in line with old fence south and west. TIES: Power Pole - S67°E - 34.26'; Cedar, 8" - S12°W - 20.49'; Cedar, 9" - N67°W - 25.07'.
- 1996: Field Notes in my office indicate that we recovered the 5/8" dia. Iron Rod and replaced it with a 2" dia. Aluminum Pipe 30" long/3-1/4" dia. Alum cap stamped for corner location.


**B. Description of corner evidence found and/or method applied in restoring or reestablishing corner:**

We found a 2" dia. Aluminum Pipe 30" long/3-1/4" dia. Alum cap stamped for corner location in position matching ties as described in L.C.R.C. No. 842 (see part A). This corner has been used for control for several surveys over the past 10 years, fits well with long standing lines of occupation, and is accepted as the best available evidence of the position of the original corner.

**C. Description of monument for corner and accessories established to perpetuate locating the position of the corner:**

Accepted existing 2" dia. Aluminum Pipe 30" long/3-1/4" dia. Alum cap stamped for corner location:

Nail in Power Pole	S67°E	34.26 feet	
8" dia. Cedar	S12°W	20.49 feet	Scr. NBT
9" dia. Cedar	N65°W	25.07 feet	Scr. NBT
Metal Survey Sign Post	South	0.92 feet	

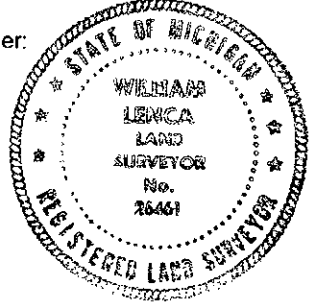

NOTE: All bearings are magnetic bearings. All distances are measured with steel tape. Distances to trees are to nail in side of tree.

Signed by William Lenca 26461  
Surveyor's Michigan License No. \_\_\_\_\_

Date Dec. 22, 1999

52