Approved by Menominee County
Land Survey Remonumentation
Peer Group Under Act 345 Of
P.A. Of 1990 On 12/12 1996
Chairman

LAND CORNER RECORDATION CERTIFICATE
Filing Requirement of Act 74, Mich. P.A. 1970

For corners in

MENOMINEE (County)

	Located In:		Corner Code #
1. Public Land Survey		T36N R 26W	L-1
		T___ R___	
		T37 R26	L-13
		T___ R___	
2. Property Controlling in Section	S___	T___ R___	
	S___	T___ R___	
3. Miscellaneous Property in Sec.	S___	T___ R___	
	S___	T___ R___	

RECEIVED FOR RECORD
96 DEC 20 AM 9:34
RECORDED AND RETURNED
PAGE # 386, 13K 4
REGISTER OF DEEDS

Register of Deeds Stamp & File Number

4. Lot No. _____ , Recorded Plat _____
5. Private Claims _____

SAME AS CORNER L-13 T37N-R26W

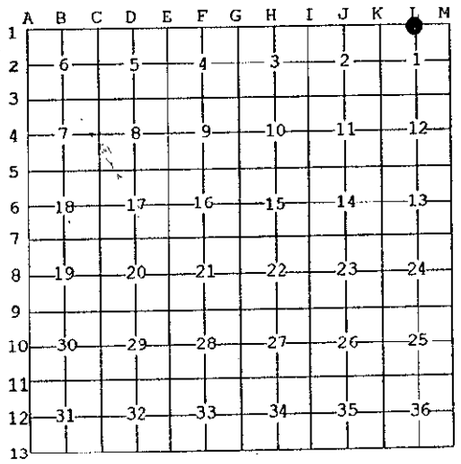

I, William Lenca, in a field survey on Sept. 18, 19 96 do hereby state that under requirements of P.A. 74, Michigan P.A. of 1970, the corner points mentioned in lines 1 and 2 above were in conformance with regulations and rules therefore as required in the current manual of survey instructions of the United States Department of the Interior, Bureau of Land Management or by a decree of a Court of Law and /or that the corner points mentioned in lines 3, 4 and 5 above were in conformance with the rules of the Michigan Board of Land Surveyors or by a Decree of a Court of Law; established, re-established, monumented, recovered, found as expressed below:

NOTE: Not more than 2 corners, all in the same town and range, may be recorded on this certificate.

A. Description of original monument and accessories and/or subsequent restoration:

1848: Original Survey by H. Brevoort - B.T.'s - Cedar, 4" - N46°E - 18 lks; Cedar, 12" - N17°W - 20 lks. All original evidence for this corner has been destroyed by fire and logging activities.

B. Description of corner evidence found and/or method applied in restoring or reestablishing corner:

We located the single proportional position for this corner between the NW Corner and the NE Corner of Section 1, T36N-R26W, and searched this area for original evidence. Finding no such evidence, we set the corner at the above mentioned proportional location and found that it fit well with a GLO terrain call to a swamp edge 198 feet to the west. We accepted this location as a careful and faithful reestablishment of the position of the original corner.

C. Description of monument for corner and accessories established to perpetuate locating the position of the corner:
Set 2" dia. Aluminum Pipe/3-1/4" dia. Alum cap stamped for corner location:

10" dia. Cedar	N20°E	27.32 feet	Scr. NBT
18" dia. Cedar	S82°E	32.81 feet	Scr. NBT
16" dia. Cedar	S00°W	24.03 feet	Scr. NBT
5" dia. Cedar	N67°W	15.28 feet	Scr. NBT
Metal Survey Sign Post	South	0.8 feet	

NOTE: All bearings are magnetic bearings. All distances are measured with steel tape. Distances to trees are to nail in side of tree.

Signed by William Lenca Date Oct. 07, 1996
Surveyor's Michigan License No. 26461

FORM APPROVED BY MICHIGAN STATE BOARD OF PROFESSIONAL SURVEYORS, JAN. 28, 197
REVISED MAY 14,197
REVISED JAN., 198
REVISED OCT., 199