

LAND CORNER RECORDATION CERTIFICATE
 Filing Requirement of Act 74, Mich. P.A. 1970

For corners in

<u>MENOMINEE</u> (County)	Located In:	Corner Code #
1. Public Land Survey	T <u>37</u> N R <u>26</u> W	<u>A02</u>
2. Property Controlling in Section	T ___ R ___	<u>M-2</u> ✓
3. Miscellaneous Property in Sec.	S ___ T ___ R ___	___
	S ___ T ___ R ___	___
	S ___ T ___ R ___	___
	S ___ T ___ R ___	___

RECEIVED FOR RECORDS
 96 OCT -7 PM 3:26
 PAGE # 362 BK. 4
 BARBARA MORRISON
 REGISTERED LAND SURVEYOR
 LICENSE NO. 26461

Register of Deeds Stamp & File Number

4. Lot No. _____, Recorded Plat _____
 5. Private Claims _____

SAME AS CORNER M-02 T37N-R26W

I, William Lenca, in a field survey on May 15, 19 96 do hereby state that under requirements of P.A. 74, Michigan P.A. of 1970, the corner points mentioned in lines 1 and 2 above were in conformance with regulations and rules therefore as required in the current manual of survey instructions of the United States Department of the Interior, Bureau of Land Management or by a decree of a Court of Law and /or that the corner points mentioned in lines 3, 4 and 5 above were in conformance with the rules of the Michigan Board of Land Surveyors or by a Decree of a Court of Law; established, re-established, monumented, recovered, found as expressed below:

NOTE: Not more than 2 corners, all in the same town and range, may be recorded on this certificate.

	A	B	C	D	E	F	G	H	I	J	K	L	M
1													
2	6		5		4		3		2		1		
3													
4	7		8		9		10		11		12		
5													
6	18		17		16		15		14		13		
7													
8	19		20		21		22		23		24		
9													
10	30		29		28		27		26		25		
11													
12	31		32		33		34		35		36		
13													

A. Description of original monument and accessories and/or subsequent restoration:


1847: Original Survey by James H. Mullett - B.T.'s - Hemlock, 5" - N54°W - 32 lks; Sugar Maple, 8" - S54°W - 25 lks. All original evidence has been destroyed by county road improvements.

B. Description of corner evidence found and/or method applied in restoring or reestablishing corner:

Finding no original evidence, subsequent restorations or occupational evidence, we re-established this corner on a straight line and proportionately between the Northwest Corner of Section 6 (A-1) and the Southwest Corner of Section 6 (A-3). The corner thus monumented falls 4 feet West of the centerline of a North - South County Road, and is accepted as a careful and faithful reestablishment of the position of the original corner.

C. Description of monument for corner and accessories established to perpetuate locating the position of the corner:
 Set 2" dia. Aluminum Pipe/3-1/4" dia. Alum. cap stamped for corner location:

5/8" x 24" Iron Rod/2" dia. Alum. cap marked "WITNESS MARKER"	N45°E	44.65 feet	1' W. of 2" Cedar
7" dia. Cedar	S39°E	72.09 feet	Scr. NBT
7" dia. Maple	S42°W	50.24 feet	Scr. NBT
5/8" x 24" Iron Rod/2" dia. Alum. cap marked "WITNESS MARKER"	West	27.14 feet	
Metal Survey Sign Post	West	27.6 feet	

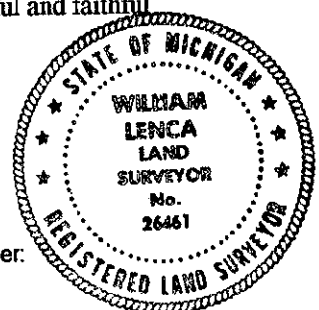

NOTE: All bearings are magnetic bearings. All distances are measured with steel tape. Distances to trees are to nail in side of tree.

Signed by William Lenca
 Surveyor's Michigan License No. 26461

Date Sep. 24, 1996