Approved by Menominee County Land Survey Remonumentation Peer Group Under Act 345 Of P.A. Of 1990 On DEC 16 1994
Alex Irwin PLS 16926
Chairman

LAND CORNER RECORDATION CERTIFICATE

Filing Requirement of Act 74, Mich. P.A. 1970

For corners in MENOMINEE (County)

RECEIVED FOR RECORD 94 DEC 27 AM 10:45 PAGE # 156 BK 4 BARBARA MORRISON REGISTER OF DEEDS MENOMINEE COUNTY, MICHIGAN 49858

Register of Deeds Stamp & File Number

		Located In:	Corner Code #
1. Public Land Survey		T 38N R 26W	M-09
		T ___ R ___	
		T 38N R 25W	A-9 ✓
		T ___ R ___	
2. Property Controlling	S ___	T ___ R ___	
in Section	S ___	T ___ R ___	
3. Miscellaneous	S ___	T ___ R ___	
Property in Sec.	S ___	T ___ R ___	

4. Lot No. ___, Recorded Plat ___
5. Private Claims ___

Same as A-09 T38N R25W

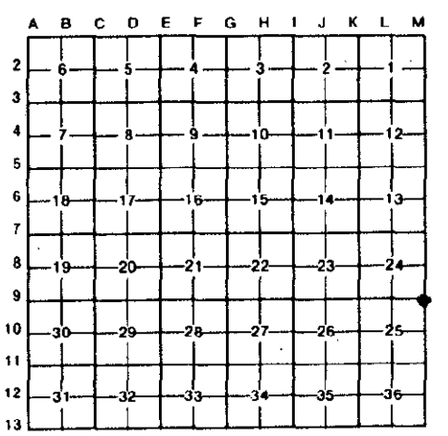

I, William Lenca, in a field survey on Jul 27, 19 94, do hereby certify that under requirements of P.A. 74, Michigan P.A. of 1970, the corner points mentioned in lines 1 and 2 above were in conformance with regulations and rules therefore as required in the current manual of survey instructions of the United States Department of the Interior, Bureau of Land Management or by a decree of a Court of Law and/or that the corner points mentioned in lines 3, 4 and 5 above were in conformance with the rules of the Michigan Board of Land Surveyors or by a Decree of a Court of Law; established, re-established, monumented, re-monumented, recovered, found as expressed below:

NOTE: Not more than 4 corners, all in the same town and range, may be recorded on this certificate.

A. Description of original monument and accessories and/or subsequent restoration:

1848: Original Survey (Township Exterior) by James H. Mullet - B.T.'s - Sugar, 10"- N39°W - 34 lks; Beech, 4" - S53°W - 32 lks - All original evidence for this corner has been destroyed by farming activities.

1899: Albert Haas, County Surveyor, made a survey of Section 25, T38N-R26W and describes this corner as "Set Cedar stake from Government B.T.

B. Description of corner evidence found and/or method applied in restoring or reestablishing corner:

In a 1987 survey of Section 24, T38N-R26W we set a 5/8" x 24" Iron rod/Ident. cap in the centerline of an old lane running West and in line with an old fence line running South. In our 1994 remonumentation of this corner, we found the 5/8" x 24" Iron Rod with a plastic identification cap set in location as described. The measurement to the 1/4 corner 1/2 mile West is 2672.51 feet compared with Haas' distance of 2666.4 feet. We accepted the existing corner as the best available evidence of the position of the original corner.

C. Description of monument for corner and accessories established to perpetuate locating the position of the corner:

Set 2-1/2" dia. alum. Pipe 30" long/3-1/4" dia. Alum. cap stamped for corner location:

Twin 9" dia. Maples	N57°E	21.77 feet	Scr. NBT
10" dia. Maple	S35°W	41.10 feet	Scr. NBT
8" dia. Maple	S65°W	30.12 feet	Scr. NBT
9" dia. White Ash	N38°W	12.66 feet	Scr. NBT
Survey Sign Post	S52°W	1.7 feet	

STATE OF MICHIGAN WILLIAM LENCA LAND SURVEYOR No. 26461 REGISTERED LAND SURVEYOR

NOTE: All bearings are magnetic bearings. All distances are measured with steel tape. Distances to trees are to nail in side of tree.

Signed by William Lenca Date Dec. 14, 1994

Surveyor's Michigan License No. 26461

FORM APPROVED BY MICHIGAN STATE BOARD OF LAND SURVEYORS, JAN. 28, 197
REVISED MAY 14, 197
REVISED JAN., 198