SURVEY & REMONUMENTATION

APR 2 4 1995

COMMISSION

Approved by Menominee County Land Survey Remonumentation Peer Group Under Act 345 Of P.A. Of 1990 On DEC 16 1994
Mez Davis PLS
ACTING Chairman

LAND CORNER RECORDATION CERTIFICATE

Filing Requirement of Act 74, Mich. P.A. 1970

For corners in MENOMINEE (County)

	Located In:	Corner Code #
1. Public Land Survey	T 38N R 25W	B-7
	T ___ R ___	
	T ___ R ___	
	T ___ R ___	
2. Property Controlling	S ___ T ___ R ___	
in Section	S ___ T ___ R ___	
3. Miscellaneous	S ___ T ___ R ___	
Property in Sec.	S ___ T ___ R ___	

RECEIVED FOR RECORD
94 DEC 27 AM 10: 46
BARBARA MORRISON
REGISTER OF DEEDS
MENOMINEE, MI 49858
PAGE # 163 BK. 4

Register of Deeds Stamp & File Number

4. Lot No. _____ , Recorded Plat _____
5. Private Claims _____

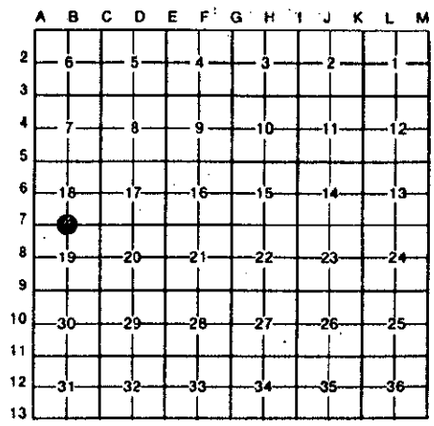

I, William Lenca, in a field survey on Sep. 06, 19 94, do hereby certify that under requirements of P.A. 74, Michigan P.A. of 1970, the corner points mentioned in lines 1 and 2 above were in conformance with regulations and rules therefore as required in the current manual of survey instructions of the United States Department of the Interior, Bureau of Land Management or by a decree of a Court of Law and/or that the corner points mentioned in lines 3, 4 and 5 above were in conformance with the rules of the Michigan Board of Land Surveyors or by a Decree of a Court of Law; established, re-established, monumented, re-monumented, recovered, found as expressed below:

NOTE: Not more than 4 corners, all in the same town and range, may be recorded on this certificate.

A. Description of original monument and accessories and/or subsequent restoration:

1852: Original Survey by George E. Adair - B.T.'s - Cedar, 10"- N59°W - 13 lks; Spruce, 10" - S27.5°E - 16 lks - All original evidence for this corner has been destroyed by farming activities.

B. Description of corner evidence found and/or method applied in restoring or reestablishing corner:

In a 1994 Survey of Section 19, T38N-R25W, we found the rotted remains of a squared wood post in line with fences North and West from this location. The post fits closely with a proportioned position for this corner, and appears to have been relied upon by local land owners. We accepted the squared wood post as the best available evidence of the position of the original corner.

STATE OF MICHIGAN
WILLIAM LENCA
LAND SURVEYOR
No. 26461
REGISTERED LAND SURVEYOR

C. Description of monument for corner and accessories established to perpetuate locating the position of the corner:

Set 2-1/2" dia. alum. Pipe 30" long/3-1/4" dia. Alum. cap stamped for corner location:

5" dia. Cedar	S69°E	17.71 feet	Scr. NBT
7" dia. Cedar	S22°W	35.72 feet	Scr. NBT
10" dia. Cedar	N80°W	38.13 feet	Scr. NBT
7" dia. Cedar	N12°E	61.18 feet	Scr. NBT
Survey Sign Post	N12°E	1.2 feet	

NOTE: All bearings are magnetic bearings. All distances are measured with steel tape. Distances to trees are to nail in side of tree.

Signed by William Lenca Date Sep. 15, 1994

Surveyor's Michigan License No. 26461

FORM APPROVED BY MICHIGAN STATE BOARD OF LAND SURVEYORS, JAN. 28, 1971
REVISED MAY 14, 1975
REVISED JAN., 1983